

MARSHALL
P 30
10-16-71

MISSISSIPPI
 BOARD OF WATER COMMISSIONERS NOV 18 1971
 416 North State Street
 Jackson, Mississippi 39201

CODED

MISS. BD. OF

WELL WELL DRILLERS LOG

10-16 1971 Dean Kent Superwell MARSHALL
 date well completed firm name county well located

LANDOWNER:

Jeddie B. Robinson

Holly Springs, Miss. Rt 11
 (mailing address)

description of formations encountered

description of formations encountered	from	to
clay	0	15
sand	15	70

WELL LOCATION:

sec. 26 T. X N. R. 2 E.
 (distance) 8 miles South East of Holly Springs
 (direction) (nearest town)

WELL PURPOSE: Drilling
 (home, irrigation, municipal, industrial)

WELL COMPLETION DATA:


- (1) diameter (inches) 4"
- (2) total depth (feet) 70 feet
- (3) static water level (feet) 48 ft below above top of ground.
- (4) casing PVC, 70 feet
 (material) (depth)
 (size) If telescope see back.
- (5) screen 4 ft., 62 feet
 (length) (depth to top)
4" gravel wall
 (size) (material)
- (6) pump 1/2 10
 (HP) (yield gpm)
elect
 (type power)
- (7) electric log no
 (yes or no)
- (organization running log)
- (8) how well bottom plugged 4" cap

CODED

DRILLERS REMARKS:

If well telescopes please sketch and show depths.

GROUND LEVEL

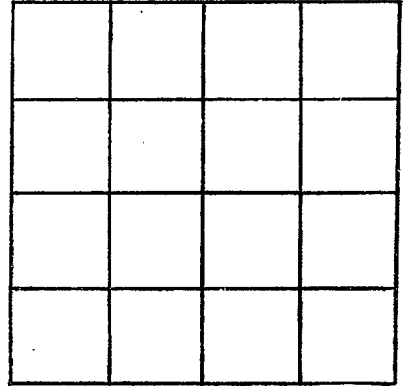

SECTION _____

Please indicate well location X.

ADDITIONAL INFORMATION

If more than one screen,
show locations of each on sketch.