

**MARSHALL**  
**P32**  
**3-28-72**

MISSISSIPPI  
 BOARD OF WATER COMMISSIONERS  
 416 North State Street  
 Jackson, Mississippi 39201

**CODED**

**WATER WELL DRILLERS LOG**

March 28 1972 Atkinson-Frost Marshall  
 date well completed firm name county well located

LANDOWNER:  
Perdie Phillips  
Bally Spring Miss  
 (mailing address)

description of formations encountered	from	to
<u>red sand</u>	<u>0</u>	<u>100</u>
<u>white sand</u>	<u>100</u>	<u>140</u>

WELL LOCATION:  
 sec. 1 T. 4 N R. 2 E  
2 miles S of Bally Spring  
 (distance) (direction) (nearest town)

WELL PURPOSE: Home  
 (home, irrigation, municipal, industrial)

- WELL COMPLETION DATA:
- (1) diameter (inches) 4"
  - (2) total depth (feet) 140
  - (3) static water level (feet) 110 below top of ground.
  - (4) casing P.V.C. 140  
 (material) (depth)  
 (size) if telescope see back.
  - (5) screen 10 130  
 (length) (depth to top)  
4" P.V.C.  
 (size) (material)
  - (6) pump 1/2 10  
 (HP) (yield gpm)  
Etc.  
 (type power)
  - (7) electric log NO  
 (yes or no)
  - (organization running log)
  - (8) how well bottom plugged CAP

**CODED**


APR 12 1972

MISS. Bd. OF  
 WATER

DRILLERS REMARKS:

If well telescopes please sketch and show depths.

GROUND LEVEL

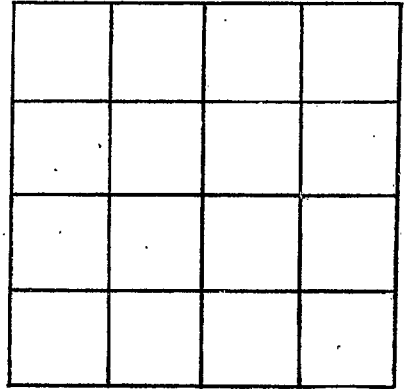

SECTION \_\_\_\_\_

Please indicate well location X.

ADDITIONAL INFORMATION

If more than one screen, show locations of each on sketch.