

**MARSHALL**  
**P 33**  
**5-15-72**

MISSISSIPPI  
 BOARD OF WATER COMMISSIONERS  
 416 North State Street  
 Jackson, Mississippi 39201

**CODED**

WATER WELL DRILLERS LOG

5-15-1972 date well completed  
 Dean + Kent Springs wells firm name  
 Marshall county well located

LANDOWNER:  
 Live Mae Depley  
 Halls Springs, Miss.  
 (mailing address)

description of formations encountered	from	to
clay	0	30
sand	30	150

WELL LOCATION:  
 sec. 24 T. 4 N. R. 2 E.  
 8 miles South of Halls Springs  
 (distance) (direction) (nearest town)

WELL PURPOSE: Drinking  
 (home, irrigation, municipal, industrial)

- WELL COMPLETION DATA:
- (1) diameter (inches) 4"
  - (2) total depth (feet) 150 feet
  - (3) static water level (feet) 120 below above top of ground.
  - (4) casing PVC 1.50 feet  
 (material) (depth)  
 (size) if telescope see back.
  - (5) screen 7 ft. 143  
 (length) (depth to top)  
4" gravel in well  
 (size) (material)
  - (6) pump 3/4 14  
 (HP) (yield gpm)  
 (type power)
  - (7) electric log Electric  
 (yes or no)  
 (organization running log)
  - (8) how well bottom plugged 4" cap

**CODED**

APR 10 1972


DRILLERS REMARKS:

MISSISSIPPI  
 BOARD OF WATER COMMISSIONERS  
 JACKSON, MISSISSIPPI

If well telescopes please sketch and show depths.



GROUND LEVEL

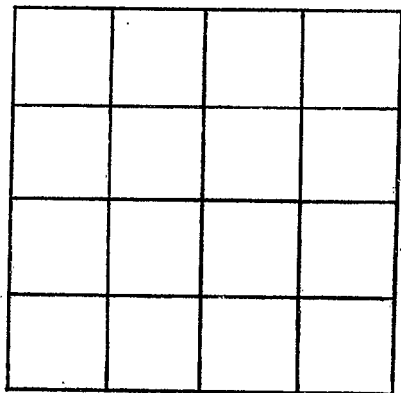

SECTION \_\_\_\_\_

Please indicate well location X.

ADDITIONAL INFORMATION

If more than one screen,  
show locations of each on sketch.