

**MARSHALL**  
**P 36**  
**11-28-71**

MISSISSIPPI  
 BOARD OF WATER COMMISSIONERS  
 416 North State Street  
 Jackson, Mississippi 39201

**CODED**

WATER WELL DRILLERS LOG

Nov. 29 1971 R. L. Carpenter Marshall  
 date well completed firm name county well located


LANDOWNER: <u>Evans Moore</u>	description of formations encountered	from	to
<del>Holly Springs</del> <u>Holly Springs</u> Miss. (mailing address)			
WELL LOCATION: sec. <u>3</u> T <u>4</u> N R <u>2</u> E <u>3</u> miles <u>East</u> of <u>Holly Springs</u> (distance) (direction) (nearest town)	med. Red Sand	21	45
WELL PURPOSE: <u>Home</u> (home, irrigation, municipal, industrial)	Red Clay	45	63
WELL COMPLETION DATA: (1) diameter (inches) <u>4</u> (2) total depth (feet) <u>265</u> (3) static water level (feet) <u>225</u> below top of ground. (4) casing <u>Plastic</u> , <u>259 ft.</u> (material) (depth) (size) If telescope see back. (5) screen <u>6 ft.</u> , <u>259 ft.</u> (length) (depth to top) <u>4 in.</u> , <u>Plastic &amp; Hard</u> (size) (material) (6) pump <u>3/4</u> , <u>10</u> (HP) (yield gpm) <u>Elec.</u> (type power) (7) electric log <u>No</u> (yes or no) (organization running log) (8) how well bottom plugged <u>Plastic cap</u>	fine-med. white sand	63	150
	White Clay & Fine Sand	150	205
	White Coarse Sand	205	265
DRILLERS REMARKS:			

**CODED**

AUG - 4 1972

If well telescopes please sketch and show depths.

GROUND LEVEL

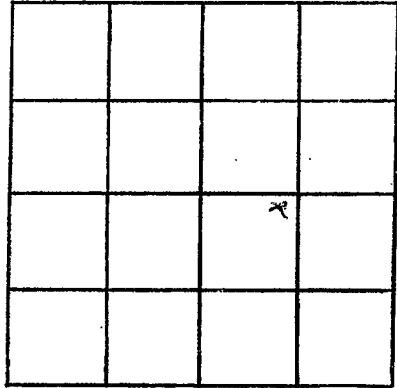

SECTION 3

Please indicate well location X.

ADDITIONAL INFORMATION

If more than one screen, show locations of each on sketch.