

MARSHALL  
P 38  
11-27-72


MISSISSIPPI  
 BOARD OF WATER COMMISSIONERS  
 416 North State Street  
 Jackson, Mississippi 39201  
 WATER WELL DRILLERS LOG

11-27 1972 HICKS Brothers Well Co. MARSHAL  
 date well completed firm name county well located

LANDOWNER: <u>Cleveland Collins</u>	description of formations encountered	from	to
<u>Holly Springs, Miss</u>	<u>Red CLAY</u>	<u>0</u>	<u>15</u>
(mailing address)	<u>White SAND</u>	<u>15</u>	<u>85</u>
WELL LOCATION:	<u>White SANDY CLAY</u>	<u>85</u>	<u>105</u>
sec. <u>7</u> T. <u>4</u> N. R. <u>2</u> E	<u>White SAND</u>	<u>105</u>	<u>145</u>
<u>2</u> miles <u>S</u> of <u>Holly Springs</u>			
(distance) (direction) (nearest town)			
WELL PURPOSE: <u>HOME</u> (home, irrigation, municipal, industrial)			
WELL COMPLETION DATA:			
(1) diameter (inches) <u>4"</u>			
(2) total depth (feet) <u>145</u>			
(3) static water level (feet) <u>94</u> below above top of ground.			
(4) casing <u>PLASTIC</u> , <u>139</u> (material) (depth)			
(size) if telescope see back.			
(5) screen <u>6'</u> , <u>6'</u> (length) (depth to top)			
(size) <u>4"</u> , <u>Gravel PLASTIC</u> (material)			
(6) pump <u>3/4</u> , <u>10</u> (HP) (yield gpm)			
<u>220 Elec</u> (type power)			
(7) electric log <u>NO</u> (yes or no)			
(organization running log)			
(8) how well bottom plugged <u>CAP</u>			
DRILLERS REMARKS:			
	<u>NOV 30 1972</u>		

If well telescopes please sketch and show depths.

GROUND LEVEL

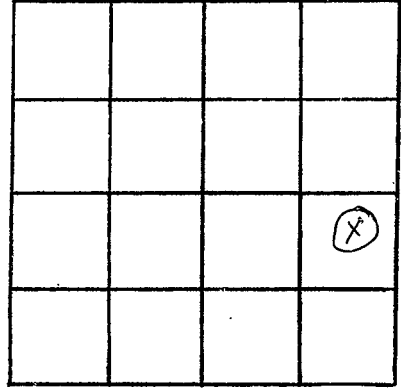

SECTION \_\_\_\_\_

Please indicate well location X.

ADDITIONAL INFORMATION

A series of horizontal lines for writing additional information.

If more than one screen, show locations of each on sketch.