

MARSHALL

P40

11-20-72

MISSISSIPPI BOARD OF WATER COMMISSIONERS 416 North State Street Jackson, Mississippi 39201

WATER WELL DRILLERS LOG

11-20 date well completed

1972 HICKS BROTHERS WELL CO firm name

Marshall county well located

LANDOWNER: JOHNNIE D. WALLS P.O. 244 HOLLY SPRINGS, MISS (mailing address)

Table with 3 columns: description of formations encountered, from, to. Entries: Red clay (0-15), Red sand (15-65), White sand (65-159)

WELL LOCATION: sec 27 T 4 N R 2 E 2 1/2 miles N.E. of HOLLY SP (distance) (direction) (nearest town)

WELL PURPOSE: HOME (home, irrigation, municipal, industrial)


- WELL COMPLETION DATA: (1) diameter (inches) 4" (2) total depth (feet) 159 (3) static water level (feet) 128 below top of ground. (4) casing PLASTIC, 154 (material) (depth) (size) if telescope see back. (5) screen 6' (length), 6' (depth to top) 4" PLASTIC GRAVEL (size) (material) (6) pump 1/3 (HP) 10 (yield gpm) 220 BREL (type power) (7) electric log NO (yes or no) (organization running log) (8) how well bottom plugged CAP

DRILLERS REMARKS:

NOV 30 1972

If well telescopes please sketch and show depths.

GROUND LEVEL

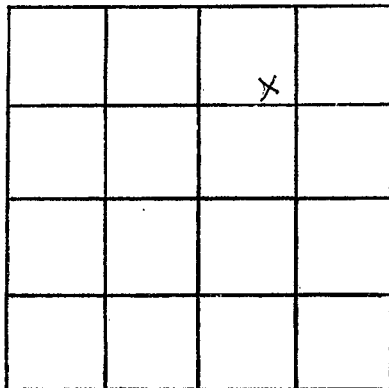

SECTION _____

Please indicate well location X.

ADDITIONAL INFORMATION

If more than one screen,
show locations of each on sketch.