

**MARSHALL**  
**P 42**  
**10-15-72**

MISSISSIPPI  
 BOARD OF WATER COMMISSIONERS  
 416 North State Street  
 Jackson, Mississippi 39201

**CODED**

**WATER WELL DRILLERS LOG**

Oct. 15 1972 R. L. Carpenter Marshall  
 date well completed firm name county well located

LANDOWNER: Samuel E. Bell  
Holly Springs, Miss.  
 (mailing address)

WELL LOCATION:  
 sec. 7 T 4 N R 2 E  
1 miles South of Holly Springs  
 (distance) (direction) (nearest town)

WELL PURPOSE: Home  
 (home, irrigation, municipal, industrial)

WELL COMPLETION DATA:

- (1) diameter (inches) 4 in
- (2) total depth (feet) 225
- (3) static water level (feet) 155 below top of ground.
- (4) casing Plastic, 219 ft  
 (material) (depth)  
 (size) if telescope see back.
- (5) screen 4 ft, 219 ft  
 (length) (depth to top)  
4 in Plastic or Ground  
 (size) (material)
- (6) pump 3/4, 10  
 (HP) (yield gpm)  
Electric  
 (type power)
- (7) electric log no  
 (yes or no)
- (organization running log)
- (8) how well bottom plugged Plastic Plug

description of formations encountered	from	to
<u>Surface Soil</u>	<u>8</u>	<u>19</u>
<u>Med. Red Sand</u>	<u>19</u>	<u>45</u>
<u>Med. white sand</u>	<u>45</u>	<u>85</u>
<u>white clay</u>	<u>85</u>	<u>89</u>
<u>white Fine Sand</u>	<u>89</u>	<u>126</u>
<u>white clay</u>	<u>126</u>	<u>132</u>
<u>Med. white sand</u>	<u>132</u>	<u>180</u>
<u>white coarse sand</u>	<u>180</u>	<u>225</u>


**CODED**

FEB 19 1973

DRILLERS REMARKS:

If well telescopes please sketch and show depths.

GROUND LEVEL

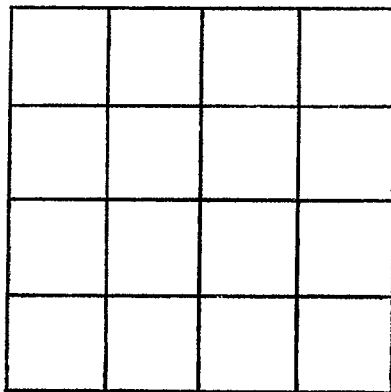

SECTION \_\_\_\_\_

Please indicate well location X.

ADDITIONAL INFORMATION

If more than one screen, show locations of each on sketch.