

MARSHALL
P43
4-6-73

MISSISSIPPI
BOARD OF WATER COMMISSIONERS
416 North State Street
Jackson, Mississippi 39201

CODED

WATER WELL DRILLERS LOG

4-6-1973 Hicks Bros Wells, Marshal
date well completed firm name county well located

LANDOWNER: Lee M & Shugart

Description of formations encountered

from to

Holly Springs, Miss
(mailing address)

Red Clay	0	15
White Clay	15	25
Black Clay	25	40
White Clay	40	60
White Clay + Sand	60	80
White Sand	80	210

WELL LOCATION:

sec. 4 T 4 N R 2 E
1/2 miles East of H.S.
(distance) (direction) (nearest town)

WELL PURPOSE: Home
(home, irrigation, municipal, industrial)

WELL COMPLETION DATA:

- (1) diameter (inches) 4 in.
(2) total depth (feet) 210
(3) static water level (feet) 165 below above top of ground.
(4) casing Plastic, 210
(material) (depth)

_____ if telescope see back.
(size)

- (5) screen 4 ft, 206
(length) (depth to top)

4 in, Shovel
(size) (material)

- (6) pump 3/4 10
(HP) (yield gpm)

Electric 220
(type power)

- (7) electric log No
(yes or no)

_____ (organization running log)

- (8) how well bottom plugged Cap


DRILLERS REMARKS:

CODED

APR 10 1973

If well telescopes please sketch and show depths.

GROUND LEVEL

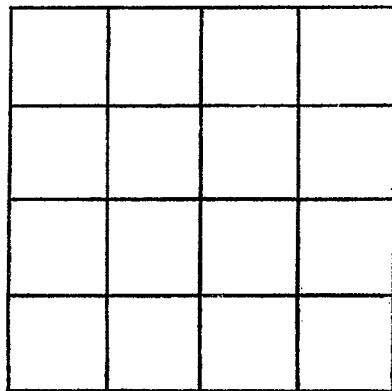

SECTION _____

Please indicate well location X.

ADDITIONAL INFORMATION

*If more than one screen,
show locations of each on sketch.*