

MARSHALL

P44

3-26-73

MISSISSIPPI BOARD OF WATER COMMISSIONERS 416 North State Street Jackson, Mississippi 39201

WATER WELL DRILLERS LOG

CODED

3-26-1973 Ducks Bros. W.M.B. date well completed firm name

Marshall county well located

LANDOWNER: Jimmy Hart	description of formations encountered	from	to			
Route 1, Dolly Springs				Red Clay	0	15
Miss. 38635 (mailing address)				Red Sand	15	50
	White Sand	50	100			

WELL LOCATION: sec. 35 T 4 N R 2 E 6 miles SE of H.S. (distance) (direction) (nearest town)

WELL PURPOSE: Home (home, irrigation, municipal, industrial)

WELL COMPLETION DATA:

- (1) diameter (inches) 4 in.
- (2) total depth (feet) 100 ft.
- (3) static water level (feet) 80 below top of ground.
- (4) casing Plastic, 100 ft. (material) (depth)

(size) if telescope see back.

- (5) screen 4 ft., 96 ft. (length) (depth to top)

4 in. gravel (size) (material)

- (6) pump 3/4 HP, 10 GPM (HP) (yield gpm)

Electric, 200 (type power)

- (7) electric log No (yes or no)

(organization running log)

- (8) how well bottom plugged Cap


DRILLERS REMARKS:

CODED

APR 21 1973

If well telescopes please sketch and show depths.

GROUND LEVEL

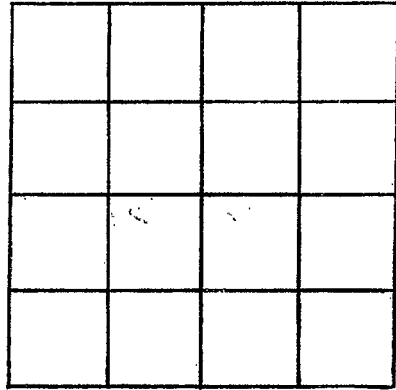

SECTION _____

Please indicate well location X.

ADDITIONAL INFORMATION

A series of horizontal lines for recording additional information, starting below the 'ADDITIONAL INFORMATION' header and extending to the bottom of the page.

If more than one screen, show locations of each on sketch.