

MARSHALL

P 45

7-23-73

MISSISSIPPI
 BOARD OF WATER COMMISSIONERS
 416 North State Street
 Jackson, Mississippi 39201

CODED

WATER WELL DRILLERS LOG

6-14

date well completed

1973

firm name

Dean Hart Burgess well Marshall
county well located

LANDOWNER:	description of formations encountered	from	to
		Eugene Collins	0
Nelly Springs, Miss. (mailing address)	Clay Sand	20	100

WELL LOCATION:
 sec 35 T 4 N R 2 E
 1/2 miles West of Lepanto
 (distance) (direction) (nearest town)

WELL PURPOSE: Drinking
 (home, irrigation, municipal, industrial)

- WELL COMPLETION DATA:
- (1) diameter (inches) 4"
 - (2) total depth (feet) 100 feet
 - (3) static water level (feet) 78 feet below top of ground.
 - (4) casing PVC (material) 100 feet (depth)
 - (size) If telescope see back.
 - (5) screen 8 feet (length) 92 feet (depth to top)
 - 5" (size) gravel wool (material)
 - (6) pump 3/4 (HP) 12 (yield gpm)
 - (type power)
 - (7) electric log elect. (yes or no)
 - (organization running log)
 - (8) how well bottom plugged 4" cof.


CODED

DRILLERS REMARKS:

MISSISSIPPI

If well telescopes please sketch and show depths.

GROUND LEVEL

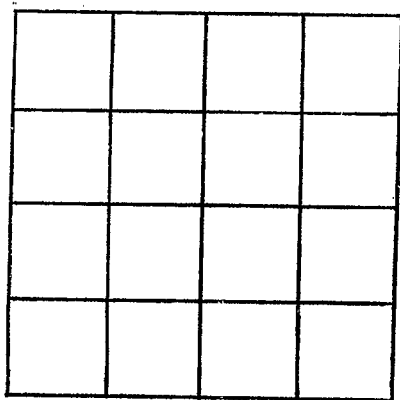

SECTION _____

Please indicate well location X.

ADDITIONAL INFORMATION

Lined area for additional information.

If more than one screen, show locations of each on sketch.