

MARSHALL
P 48
11-16-72

MISSISSIPPI
 BOARD OF WATER COMMISSIONERS
 416 North State Street
 Jackson, Mississippi 39201

WATER WELL DRILLERS LOG

CODED

Nov. 16 1972 R. L. Caperton Marshall
 date well completed firm name county well located

LANDOWNER: James Colman
 Holly Springs, Miss
 RFD
 (mailing address)

description of formations encountered	from	to
surface soil	0	20
med. red sand	20	38
med. white sand	38	70
white sand & white clay	70	96
white coarse sand	96	127

WELL LOCATION:
 sec. 22 T 4 N R 2 E
 3 miles S of Holly Springs
 (distance) (direction) (nearest town)

WELL PURPOSE: Home
 (home, irrigation, municipal, industrial)

- WELL COMPLETION DATA:
- (1) diameter (inches) 4
 - (2) total depth (feet) 127
 - (3) static water level (feet) 75 below above top of ground.
 - (4) casing Plastic, 121 ft.
 (material) (depth)
 (size) if telescope see back.
 - (5) screen 6 ft., 121 ft.
 (length) (depth to top)
4 in., Plastic Band
 (size) (material)
 - (6) pump 3/4, 10
 (HP) (yield gpm)
elec
 (type power)
 - (7) electric log no
 (yes or no)
 (organization running log)
 - (8) how well bottom plugged Plastic Cap


CODED

DRILLERS REMARKS:

JUL 30 1973

If well telescopes please sketch and show depths.

GROUND LEVEL

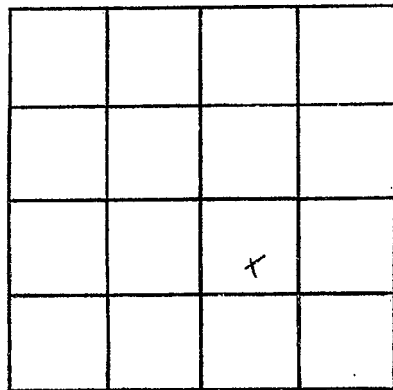

SECTION 22

Please indicate well location X.

ADDITIONAL INFORMATION

If more than one screen,
show locations of each on sketch.