

MISSISSIPPI  
BOARD OF WATER COMMISSIONER  
416 North State Street  
Jackson, Mississippi 39201

**CODED**

P 50  
MARSHALL  
6-14-73

WATER WELL DRILLERS LOG

6-14-1973 date well completed  
23 Bleib's Bros Well Marshall firm name  
county well located

LANDOWNER: Man-con  
Frans - Bleib  
Sub. Well Co. College Ave, Holly Springs, N.C.  
(mailing address)

description of formations encountered

from to

Red Clay  
Red Sand  
Red Sand + Clay  
Red Sand  
White Sand  
Red Sand  
White Sand

description of formations encountered	from	to
Red Clay	0	30
Red Sand	30	45
Red Sand + Clay	45	60
Red Sand	60	75
White Sand	75	105
Red Sand	105	120
White Sand	120	190

WELL LOCATION:  
sec. 26 T 4 N R 2 E  
3 miles S of Curtis  
(distance) (direction) (nearest town)

WELL PURPOSE: Home  
(home, irrigation, municipal, industrial)

WELL COMPLETION DATA:

- (1) diameter (inches) 4"
- (2) total depth (feet) 190
- (3) static water level (feet) 94 below top of ground.
- (4) casing Plastic 190, (material) (depth)  
         if telescope see back.  
(size)
- (5) screen 12ft, (length) (depth to top)  
4", Gravel (size) (material)
- (6) pump 1 1/2 30 GPM (HP) (yield gpm)  
Electric 220 (type power)
- (7) electric log no (yes or no)
- (8) how well bottom plugged Cap


**CODED**

DRILLERS REMARKS:

AUG 20 1973

If well telescopes please  
sketch and show depths.

GROUND LEVEL

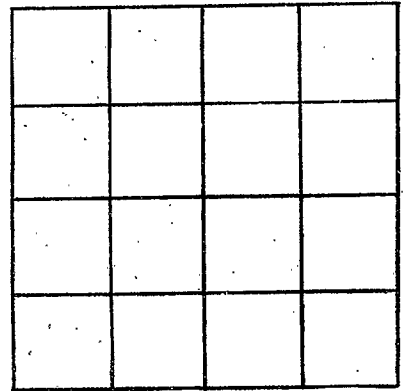

SECTION \_\_\_\_\_

Please indicate well location X.

ADDITIONAL INFORMATION

If more than one screen,  
show locations of each on sketch.