

Marshall
P 51
7-12-73

MISSISSIPPI
 BOARD OF WATER COMMISSIONERS
 416 North State Street
 Jackson, Mississippi 39201

CODED

WATER WELL DRILLERS LOG

7-12 1973 Geant Kent Burgess Marshall
 date well completed firm name county well located

LANDOWNER:
St. Mark Baptist Church
Holly Springs, Miss.
 (mailing address)

description of formations encountered	from	to
<u>clay</u>	<u>0</u>	<u>20</u>
<u>Sand</u>	<u>20</u>	<u>80</u>

WELL LOCATION:
 sec. 35 T. 4 N. R. 2 E.
5 miles South of Holly Springs
 (distance) (direction) (nearest town)

CODED

WELL PURPOSE: Private
 (home, irrigation, municipal, industrial)

- WELL COMPLETION DATA:
- (1) diameter (inches) 4"
 - (2) total depth (feet) 80 feet
 - (3) static water level (feet) 20 below above top of ground.
 - (4) casing PVC 80 feet
 (material) (depth)
 (size) if telescope see back.
 - (5) screen 8 ft 72 feet
 (length) (depth to top)
5" gravel wall
 (size) (material)
 - (6) pump 3/4 14
 (HP) (yield gpm)
 (type power)
 - (7) electric log Elect.
 (yes or no)
 (organization running log)
 - (8) how well bottom plugged 4" cap.


DRILLERS REMARKS:

SEP 11 1973

MISS. DE. OF
 WATER CONTROL

If well telescopes please sketch and show depths.

GROUND LEVEL

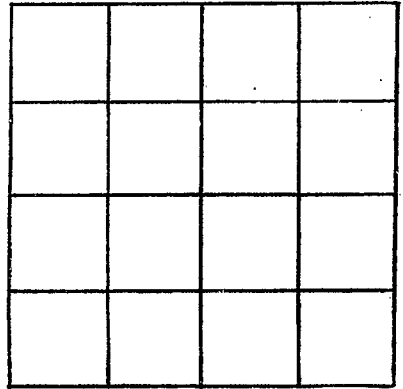

SECTION _____

Please indicate well location X.

ADDITIONAL INFORMATION

If more than one screen, show locations of each on sketch.