

Marshall

P 52

8-6-73

MISSISSIPPI BOARD OF WATER COMMISSIONERS 416 North State Street Jackson, Mississippi 39201

CODED

WATER WELL DRILLERS LOG

8-6-73 date well completed, Dean Heat Pump Co. firm name, Marshall county well located

LANDOWNER:

J. V. Murdock, Holly Springs (mailing address)

description of formations encountered

from 0 to 30

clay, sand

80 90

clay, sand

90 230

WELL LOCATION:

sec. 11 T. 4 N. R. 2 E. S. W. 5 miles East of Holly Springs (distance) (direction) (nearest town)

WELL PURPOSE: Domestic (home, irrigation, municipal, industrial)

WELL COMPLETION DATA:

- (1) diameter (inches) 4"
(2) total depth (feet) 230 feet
(3) static water level (feet) 180 below top of ground.

- (4) casing PVC, 230 feet (material) (depth)

(size) if telescope see back.

- (5) screen 7 ft, 22.3 feet (length) (depth to top)

4" gravel wall (size) (material)

- (6) pump 3/4 HP, 14 (yield gpm)

(type power)

- (7) electric log (yes or no)

(organization running log)

- (8) how well bottom plugged 4" cap.

CODED


SEP 11 1973

MISS. BD. OF WATER COMMISSIONERS

DRILLERS REMARKS:

If well telescopes please sketch and show depths.

GROUND LEVEL

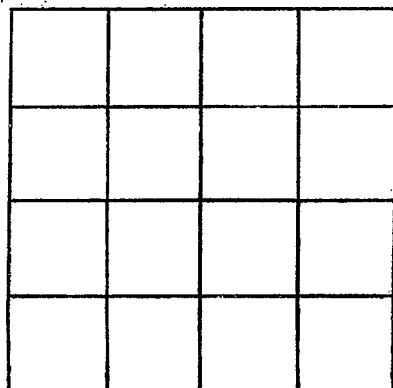

SECTION \_\_\_\_\_

Please indicate well location X.

ADDITIONAL INFORMATION

If more than one screen,  
show locations of each on sketch.