

Marshall

P 53

8-27-73

MISSISSIPPI BOARD OF WATER COMMISSIONERS
416 North State Street
Jackson, Mississippi 39201

CODED

WATER WELL DRILLERS LOG

8-27-73 date well completed
Resort Kent Bunk firm name
MARSHALL county well located

LANDOWNER:

W. E. Brown

Holly Springs, Miss.
(mailing address)

WELL LOCATION:

sec. 26 T. 4 N. R. 2 E. S. 3
7 miles South of Holly Springs
(distance) (direction) (nearest town)

WELL PURPOSE: Domestic
(home, irrigation, municipal, industrial)

WELL COMPLETION DATA:

- (1) diameter (inches) 4"
- (2) total depth (feet) 150 feet
- (3) static water level (feet) 60' below top of ground.
- (4) casing PVC 150 feet (material) (depth)
- (5) screen 7' to 143 feet (length) (depth to top)
- (6) pump 4" 3/4 HP (size) (material) (yield gpm)
- (7) electric log (yes or no)
- (8) how well bottom plugged 4" cap.

description of formations encountered

from

to

clay

0 20

sand

20 50

clay

50 60

sand

60 150

CODED


DRILLERS REMARKS:

SEP 11 1973

MISS. BD. OF WATER COMMISSIONERS

If well telescopes please sketch and show depths.

GROUND LEVEL

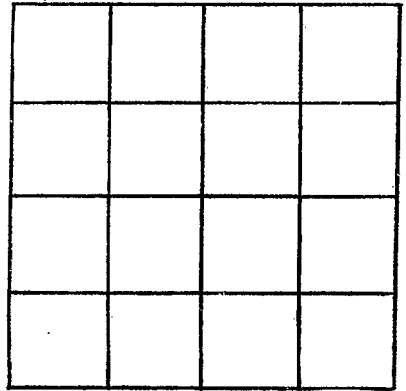

SECTION _____

Please indicate well location X.

ADDITIONAL INFORMATION

If more than one screen,
show locations of each on sketch.