

**MARSHALL**  
**P55**  
**10-3-73**

MISSISSIPPI  
 BOARD OF WATER COMMISSIONERS  
 416 North State Street  
 Jackson, Mississippi 39201

**CODED**


**WATER WELL DRILLERS LOG**

10-3 1973 *Dean Hart Simpson* *Mississippi*  
 date well completed firm name county well located

LANDOWNER:	description of formations encountered	from	to
<i>Willie L. Heaps</i>	<i>clay</i>	<i>0</i>	<i>10</i>
<i>Noel Springs, Miss.</i> (mailing address)	<i>sand</i>	<i>10</i>	<i>160</i>
<b>WELL LOCATION:</b>	<i>clay</i>	<i>160</i>	<i>165</i>
sec. <i>B</i> T. <i>4</i> N. R. <i>2</i> E. <i>2</i> miles <i>south</i> of <i>H.S.</i> (distance) (direction) (nearest town)	<i>sand</i>	<i>165</i>	<i>190</i>
<b>WELL PURPOSE:</b> <i>Drinking</i> (home, irrigation, municipal, industrial)	<b>CODED</b>		
<b>WELL COMPLETION DATA:</b>			
(1) diameter (inches) <i>4"</i>			
(2) total depth (feet) <i>190 feet</i>			
(3) static water level (feet) <i>110 feet</i> <small>below above top of ground.</small>			
(4) casing <i>PVC</i> <i>190 feet</i> (material) (depth)			
_____ (size) if telescope see back.			
(5) screen <i>4"</i> <i>183 feet</i> (length) (depth to top)			
<i>4"</i> <i>gravel</i> (size) (material)			
(6) pump <i>3/4</i> <i>14</i> (HP) (yield gpm)			
_____ (type power)			
(7) electric log <i>Elect.</i> (yes or no)			
_____ (organization running log)			
(8) how well bottom plugged <i>4" cap.</i>			
<b>DRILLERS REMARKS:</b>	<i>9/19/73</i>		

If well telescopes please sketch and show depths.

GROUND LEVEL

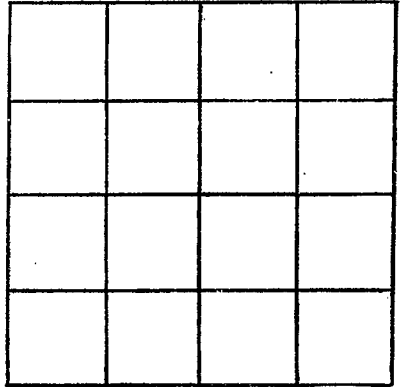

SECTION \_\_\_\_\_

Please indicate well location X.

ADDITIONAL INFORMATION

If more than one screen,  
show locations of each on sketch.