

**MARSHALL**  
**P59**  
**4-18-74**

MISSISSIPPI  
 BOARD OF WATER COMMISSIONERS  
 416 North State Street  
 Jackson, Mississippi 39201

CODED

WATER WELL DRILLERS LOG

4-18-74 date well completed  
 Shook Bros. W.M.A. firm name  
 Marshall county well located

LANDOWNER:

Susan Dickerson -  
 Bladdy Springs, Miss  
 (mailing address)

description of formations encountered	from	to
Red Sand	0	15
Red Sand white clay	15	30
white Sand & clay	30	175
white Sand	45	175

WELL LOCATION:

sec. 2 T. 4 N. R. 2 E.  
 4 miles S of Bladdy Springs  
 (distance) (direction) (nearest town)

WELL PURPOSE: Storage  
 (home, irrigation, municipal, industrial)


WELL COMPLETION DATA:

- (1) diameter (inches) 4 1/2
- (2) total depth (feet) 175
- (3) static water level (feet) 100 below top of ground.
- (4) casing Plastic, 125, (material) (depth)  
 (size) if telescope see back.
- (5) screen 4 ft, 121 (length) (depth to top)  
 4 1/2", gravel (size) (material)
- (6) pump 1/2 (HP) 3 (yield gpm)  
 Electric 110 (type power)
- (7) electric log no (yes or no)

(organization running log)

(8) how well bottom plugged Cap

DRILLERS REMARKS:

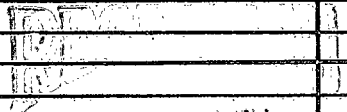

If well telescopes please sketch and show depths.

GROUND LEVEL

		X	

SECTION 2

Please indicate well location X.

ADDITIONAL INFORMATION

If more than one screen, show locations of each on sketch.