

MISSISSIPPI
BOARD OF WATER COMMISSIONERS
416 North State Street
Jackson, Mississippi 39201

CODED

WATER WELL DRILLERS LOG

MARSHALL
P 60
4-2-74

4-2-1974 date well completed 24 Elberts Bros. Wells firm name Marshall county well located

LANDOWNER:
R. T. Long Jr - D-1
Box 122, Shally Springs
(mailing address)

| description of formations encountered | from | to |
|---------------------------------------|------|-----|
| Red Clay | 0 | 15 |
| Red Sand | 15 | 45 |
| White Sand | 45 | 112 |

WELL LOCATION:
sec 16 T 4 N R 2 E
4 miles SE Shally Springs
(distance) (direction) (nearest town)

WELL PURPOSE: Home
(home, irrigation, municipal, industrial)

- WELL COMPLETION DATA:**
- (1) diameter (inches) 4 1/2
 - (2) total depth (feet) 112
 - (3) static water level (feet) 30 below above top of ground.
 - (4) casing Electric, 112
(material) (depth)
(size) if telescope see back.
 - (5) screen 4 ft, 108
(length) (depth to top)
4 1/2, Gravel
(size) (material)
 - (6) pump 1/2, 8
(HP) (yield gpm)
Electric 110
(type power)
 - (7) electric log no
(yes or no)
 - (8) how well bottom plugged Cap


CODED

DRILLERS REMARKS:

ADD 60 1974

If well telescopes please sketch and show depths.

GROUND LEVEL

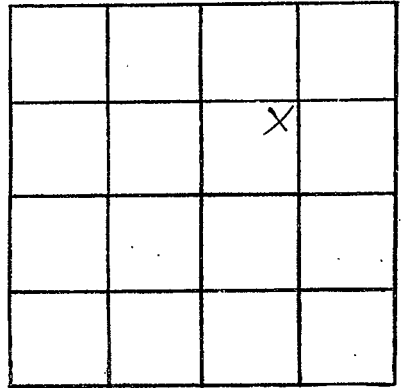

SECTION *16*

Please indicate well location X.

ADDITIONAL INFORMATION

If more than one screen,
show locations of each on sketch.