

MARSHALL

P 61

5/79

MISSISSIPPI
 BOARD OF WATER COMMISSIONERS CODED
 416 North State Street
 Jackson, Mississippi 39201

WATER WELL DRILLERS LOG

Sammie Bailey
Sammie Bailey firm name
Marshall county well located

date well completed 19 *79* firm name *Sammie Bailey* county well located *Marshall*

LANDOWNER:

Sammie Bailey

description of formations encountered

from to

Nelly Springs Miss
 (mailing address)

Beeson Clay 0 18
Red Sand 18 100
White Sand 100 200
White Clay 200 210
White Sand 210 280

WELL LOCATION:


sec. 1 T. 4 N. R. 2 E
5 miles S of *Nelly Springs*
 (distance) (direction) (nearest town)

WELL PURPOSE: *home*
 (home, irrigation, municipal, industrial)

CODED

WELL COMPLETION DATA:

- (1) diameter (inches) 4
- (2) total depth (feet) 280
- (3) static water level (feet) 220 below top of ground
- (4) casing *PVC*
 (material) (depth)
- (size) If telescope see back.
- (5) screen 270 280
 (length) (depth to top)
- (size) (material)
- (6) pump 12
 (HP) (yield gpm)
- Elec*
 (type power)
- (7) electric log no
 (yes or no)
- (organization running log)
- (8) how well bottom plugged cap.

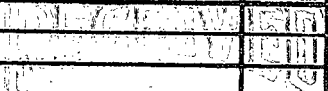


MAY 30 1979

MISS. BD. OF WATER COMM

DRILLERS REMARKS:

If well telescopes please sketch and show depths.

GROUND LEVEL

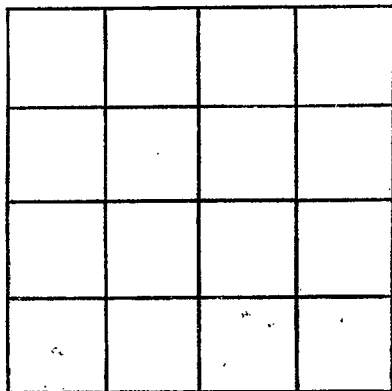

SECTION _____

Please indicate well location X.

ADDITIONAL INFORMATION

If more than one screen, show locations of each on sketch.