

MARSHALL
P 62
8-15-74


MISSISSIPPI
 BOARD OF WATER COMMISSIONERS
 416 North State Street
 Jackson, Mississippi 39201

CODED

WATER WELL DRILLERS LOG

8-15 1974 Dean Hart Surfas well Marshall
 date well completed firm name county well located


LANDOWNER:	description of formations encountered	from	to
<u>Cleveland Hicks</u>	<u>clay</u>	<u>0</u>	<u>20</u>
<u>Holly Springs, miss</u> (mailing address)	<u>Sand</u>	<u>20</u>	<u>147</u>
WELL LOCATION:			
sec. <u>26</u> T. <u>4</u> N. R. <u>2</u> E. <u>6</u> miles <u>East</u> of <u>H.S.</u> (distance) (direction) (nearest town)			
WELL PURPOSE: <u>Drinking</u> (home, irrigation, municipal, industrial)			
WELL COMPLETION DATA:			
(1) diameter (inches) <u>4"</u>			
(2) total depth (feet) <u>147 feet</u>			
(3) static water level (feet) <u>107</u> ^{below} _{above} top of ground.			
(4) casing <u>pvc</u> <u>147 feet</u> (material) (depth)			
_____ if telescope see back. (size)			
(5) screen <u>7 ft.</u> <u>140 feet</u> (length) (depth to top)			
<u>4"</u> <u>gravel wall</u> (size) (material)			
(6) pump <u>3/4</u> <u>14</u> (HP) (yield gpm)			
_____ (type power)			
(7) electric log <u>elect.</u> (yes or no)			
_____ (organization running log)			
(8) how well bottom plugged <u>4" cpl.</u>			
DRILLERS REMARKS:			

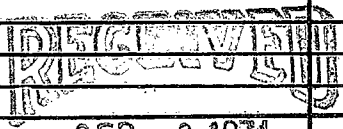

SEP - 9 1974

If well telescopes please sketch and show depths.

GROUND LEVEL

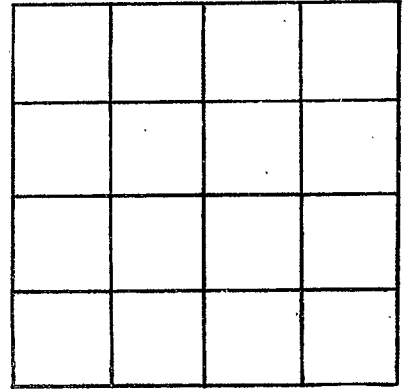

SECTION _____

Please indicate well location X.

ADDITIONAL INFORMATION

If more than one screen,
show locations of each on sketch.