

MARSHALL

P63

8-12-74

MISSISSIPPI
 BOARD OF WATER COMMISSIONERS
 416 North State Street
 Jackson, Mississippi 39201

CODED

WATER WELL DRILLERS LOG

8-12

date well completed

1974 Pump & Kent Bumpers well

firm name

Marshall

county well located

LANDOWNER:

Curtis Floyd

description of formations encountered

from

to

Holly Springs, Miss

(mailing address)

clay

0

20

WELL LOCATION:

sec. 11 T. 4 N. R. 2 E.
5 miles east of H.S.
 (distance) (direction) (nearest town)

soil

20

70

clay

70

80

soil

80

140

clay

140

150

WELL PURPOSE: Drinking
 (home, irrigation, municipal, industrial)

soil

150

230

WELL COMPLETION DATA:

- (1) diameter (inches) 4"
- (2) total depth (feet) 230 feet
- (3) static water level (feet) 190 feet below top of ground.
- (4) casing PVC 230 feet
 (material) (depth)
- (size) if telescope see back.
- (5) screen 7 ft 223 feet
 (length) (depth to top)
- 4" gravel wall
 (size) (material)
- (6) pump 3/4 12
 (HP) (yield gpm)
- (type power)
- (7) electric log Elect
 (yes or no)
- (organization running log)
- (8) how well bottom plugged 4" cop.


DECEMBER 1974
 SEP - 9 1974

MISS. BD. OF WATER COMMISSIONERS

DRILLERS REMARKS:

If well telescopes please sketch and show depths.

GROUND LEVEL

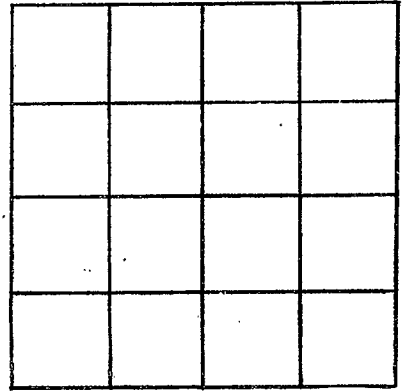

SECTION _____

Please indicate well location X.

ADDITIONAL INFORMATION

If more than one screen,
show locations of each on sketch.