

MARSHALL

P65

8/1/74

MISSISSIPPI
 BOARD OF WATER COMMISSIONERS
 416 North State Street
 Jackson, Mississippi 39201

CODED

WATER WELL DRILLERS LOG

Aug. 1
date well completed

1974 R. L. Carpenter
firm name

Marshall
county well located

LANDOWNER: S. O. Spore

Holly Springs
Miss.

(mailing address)

description of formations encountered

from to

Surface Soil 8 15

Fine Red Sand 15 29

Med. & Fine White Sand 29 60

White Clay 60 75

Med. & Coarse White Sand 75 113

WELL LOCATION:

Sec. 36 T. 4 N. R. 2 E
4 miles (distance) S of (direction) of (nearest town) Rollingwood

WELL PURPOSE: Subsidence
(home, irrigation, municipal, industrial)

WELL COMPLETION DATA:

- (1) diameter (inches) 4
- (2) total depth (feet) 113
- (3) static water level (feet) 83 below top of ground.
- (4) casing Plastic, 93 ft.
(material) (depth)

(size) if telescope see back.

- (5) screen 30 ft., 83 ft.
(length) (depth to top)
4 in., Plastic & Sand
(size) (material)

- (6) pump 1 1/2 25
(HP) (yield gpm)
Elco.
(type power)

- (7) electric log No
(yes or no)

(organization running log)

- (8) how well bottom plugged Plastic cap


DRILLERS REMARKS:

MAILED
OCT 4 1974

MISS. BD. OF WATER COMM.

If well telescopes please sketch and show depths.

GROUND LEVEL

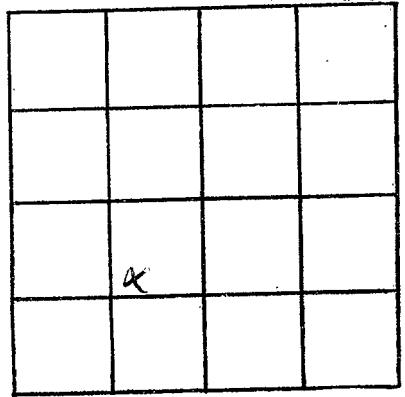

SECTION 36

Please indicate well location X.

ADDITIONAL INFORMATION

If more than one screen, show locations of each on sketch.