

MARSHALL

PL66

9-2-74

MISSISSIPPI  
 BOARD OF WATER COMMISSIONERS  
 416 North State Street  
 Jackson, Mississippi 39201

CODED

WATER WELL DRILLERS LOG

9-2-19 date well completed

H. Binkley & Sons firm name

Marshall county well located

LANDOWNER:

description of formations encountered

from

to

Clarence Bluest

Red Sand

11

30

Blenny Springs, Miss.  
(mailing address)

White Sand

30

225

WELL LOCATION:

sec. 9 T. 4 N. R. 2 E.  
 (S) (W)  
2 miles SE of Blenny  
 (distance) (direction) (nearest town)

WELL PURPOSE: drinking  
(home, irrigation, municipal, industrial)

WELL COMPLETION DATA:

- (1) diameter (inches) 4 1/2"
- (2) total depth (feet) 225
- (3) static water level (feet) 180 below top of ground.
- (4) casing Plastic, 225,  
(material) (depth)

\_\_\_\_\_ if telescope see back.  
(size)

- (5) screen 4 1/2", 221  
(length) (depth to top)

4 1/2", Screen  
(size) (material)

- (6) pump 1/2 10  
(HP) (yield gpm)

Electric, 220  
(type power)

- (7) electric log no  
(yes or no)

\_\_\_\_\_ (organization running log)

- (8) how well bottom plugged cap


DRILLERS REMARKS:

REGISTERED  
 ALL  
 SEP 25 1974

MISS. BD. OF WATER COMMISSIONERS

If well telescopes please  
sketch and show depths.

GROUND LEVEL

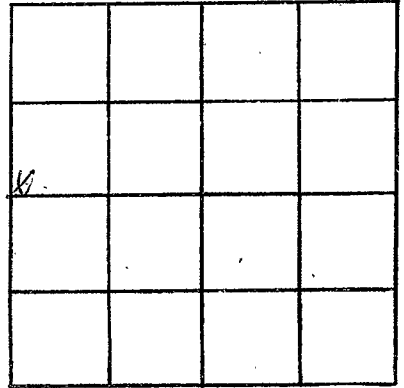

SECTION 9

Please indicate well location X.

ADDITIONAL INFORMATION

If more than one screen,  
show locations of each on sketch.