

MARSHALL  
P 67  
8-24-74

MISSISSIPPI  
BOARD OF WATER COMMISSIONERS, CODED  
416 North State Street  
Jackson, Mississippi 39201

WATER WELL DRILLERS LOG

8-24-1974 date well completed  
Sticks Bros. Well Co. firm name  
Marshall county well located

LANDOWNER:

description of formations encountered

from to

Jenny Alexander -  
Lake Center, Miss  
(mailing address)

Red clay	0	15
Red sand	15	45
White sand	45	125

WELL LOCATION:


sec 36 T 4 N R 2 E  
1/10 miles N of Lake Center  
(distance) (direction) (nearest town)

WELL PURPOSE: Home  
(home, irrigation, municipal, industrial)

WELL COMPLETION DATA:

- (1) diameter (inches) 4 1/2
- (2) total depth (feet) 125
- (3) static water level (feet) 100 below top of ground.
- (4) casing Plastic, 125, (material) (depth)
- (size) If telescope see back.
- (5) screen 16 ft, 109 (length) (depth to top)  
4 1/2, Slotted (size) (material)
- (6) pump 1/2 (HP) 10 (yield gpm)  
Electric 220 (type power)
- (7) electric log No (yes or no)
- (organization running log)
- (8) how well bottom plugged Cap

DRILLERS REMARKS:

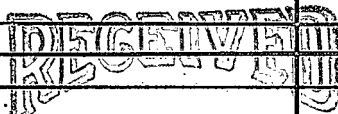

SEP 25 1974

If well telescopes please sketch and show depths.

GROUND LEVEL

		X	

SECTION 36

Please indicate well location X.

ADDITIONAL INFORMATION

If more than one screen,  
show locations of each on sketch.