

MARSHALL

P 68

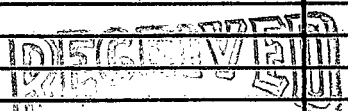
9/6/74

MISSISSIPPI  
 BOARD OF WATER COMMISSIONERS  
 416 North State Street  
 Jackson, Mississippi 39201

WATER WELL DRILLERS LOG

CODED

9-6 1974 Dean Kent Sumpner well Marshall  
 date well completed firm name county well located

LANDOWNER:	description of formations encountered	from	to
Minnie Covan	clay	0	20
Holy Springs, Miss. (mailing address)	sand	20	60
WELL LOCATION:	clay	60	65
sec. 21 T. 4 N. R. 2 E. 5 miles South of Holly Springs (distance) (direction) (nearest town)	sand	65	90
WELL PURPOSE: <u>Domestic</u> (home, irrigation, municipal, industrial)	CODED		
WELL COMPLETION DATA:			
(1) diameter (inches) <u>4"</u>			
(2) total depth (feet) <u>90 feet</u>			
(3) static water level (feet) <u>52</u> below above top of ground.			
(4) casing <u>PVC</u> , <u>90 feet</u> (material) (depth)			
_____ if telescope see back. (size)			
(5) screen <u>7 ft.</u> , <u>8 3/4 feet</u> (length) (depth to top)			
<u>1/4"</u> , <u>gravel wall</u> (size) (material)			
(6) pump <u>3/4</u> , <u>1/4</u> (HP) (yield gpm)			
_____ (type power)			
(7) electric log <u>Elect.</u> (yes or no)			
_____ (organization running log)			
(8) how well bottom plugged <u>4' cap.</u>			
DRILLERS REMARKS:	 OCT 10 1974 MISS. BD. OF WATER COMMISSIONERS		

If well telescopes please sketch and show depths.

GROUND LEVEL


SECTION \_\_\_\_\_

Please indicate well location X.

ADDITIONAL INFORMATION

If more than one screen, show locations of each on sketch.