

Marshall

P69

10/19/79

MISSISSIPPI BOARD OF WATER COMMISSIONERS  
416 North State Street  
Jackson, Mississippi 39201

CODED

WATER WELL DRILLERS LOG

10-19-79 date well completed  
Hicks Bros. Well Co. firm name  
Marshall county well located

LANDOWNER:

Free Branch Church

description of formations encountered

from to

P.O. Holly Springs, Ms  
(mailing address)

Red Clay

0 15

Red Sand

15 30

WELL LOCATION:

sec 2 T 4 N R 2 E  
3 1/2 miles E of Holly Springs  
(distance) (direction) (nearest town)

White Sand

30 75

White Sand & Clay

75 90

WELL PURPOSE: Home  
(home, irrigation, municipal, industrial)

White Sand

90 208

WELL COMPLETION DATA:

- (1) diameter (inches) 4 in.
- (2) total depth (feet) 208
- (3) static water level (feet) 195 below top of ground.
- (4) casing Plastic, 208, (material) (depth)

if telescope see back. (size)

- (5) screen 4 ft, 20 ft (length) (depth to top)

1/2 Gravel (size) (material)

- (6) pump 1/2 HP, 10 (yield gpm)

220 Electric (type power)

- (7) electric log No (yes or no)

(organization running log)

- (8) how well bottom plugged Cap

CODED


DRILLERS REMARKS:

RECEIVED  
OCT 20 1979

RD. DEPT. OF AGRICULTURE

If well telescopes please sketch and show depths.

GROUND LEVEL

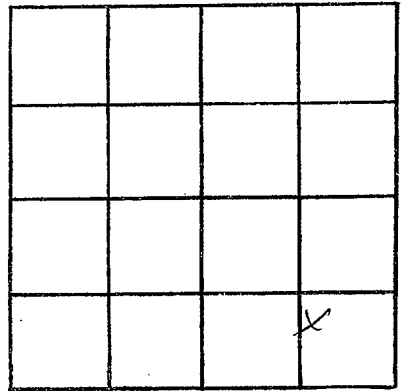

SECTION 2

Please indicate well location X.

ADDITIONAL INFORMATION

If more than one screen,  
show locations of each on sketch.