

Marshall
P 70
7-7-75

MISSISSIPPI
BOARD OF WATER COMMISSIONERS
416 North State Street
Jackson, Mississippi 39201

WATER WELL DRILLERS LOG

7-7 1975 Dearypent Bunker Marshall
date well completed firm name county well located

LANDOWNER:
Richard Danah
Nelly Springs ms
(mailing address)

description of formations encountered	from	to
Clay	0	20
Sand	20	80
Clay	80	87
Sand	87	98

WELL LOCATION:
sec. 35 T. 4 N. R. 2 E
5 miles South of Nelly Springs
(distance) (direction) (nearest town)

WELL PURPOSE: Drilling
(home, irrigation, municipal, industrial)

WELL COMPLETION DATA:

(1) diameter (inches) 4"

(2) total depth (feet) 98 feet

(3) static water level (feet) 72 below above top of ground.

(4) casing pvc, 98 feet
(material) (depth)

(size) if telescope see back.

(5) screen 8 ft., 90 feet
(length) (depth to top)

4", gravel wall
(size) (material)

(6) pump 1/2, 10
(HP) (yield gpm)

(type power)

(7) electric log Elect.
(yes or no)


(organization running log)

(8) how well bottom plugged 4" cap.

DRILLERS REMARKS:

If well telescopes please sketch and show depths.

GROUND LEVEL

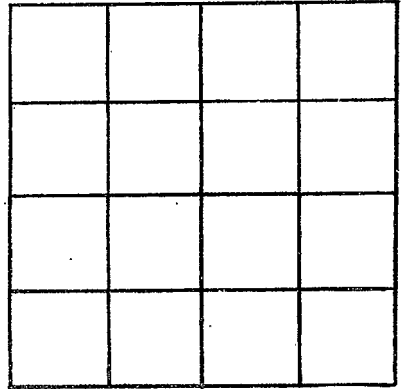

SECTION _____

Please indicate well location X.

ADDITIONAL INFORMATION

If more than one screen, show locations of each on sketch.