

Marion Water Wells, LLC

93

County: Marshall
 Permit #: _____
 Driller: James W Mason
 Date drilling completed: 8-28-04

Well Driller Report and Well Log

Mississippi Department of Environmental Quality
 Office of Land and Water Resources
 P.O. Box 10631
 Jackson, MS 39289-0631
 (601)961-5210
 (601)354-6938 (fax)

For Office Use Only:
 Aquifer: _____
 Well #: P-80
 L. S. Elevation: _____
 E-log #: _____

State Law requires that this report be prepared by the driller in detail and filed with the Department within 30 days of completion of drilling of the well.

Well Owner Information	Well Location
Owner Name: <u>Rick Hudson</u>	Latitude: <u>34° 44' 02" N</u> Longitude: <u>89° 23' 25" W</u>
Mailing Address: <u>Bullock rd.</u>	Method of Lat/Long (circle one): <u>Conventional Survey</u>
<i>*Cust has NO physical address</i> <u>at the very end.</u>	USGS quad, <u>(Hand-held GPS)</u> Survey-grade GPS
<u>Holly Springs MS 38635</u>	<u>NE 1/4 SW 1/4 Sec 11 Twn 45 Rng 2W</u>
City State Zip Code	Distance <u>2.14</u> Miles Direction <u>SE</u> of <u>Holly Springs</u>
Telephone No. <u>(901) 301-8201</u>	

Well Data

Purpose of Well (circle one) Home Industrial Public Supply Irrigation Fish Culture Other: _____

Date well drilling started: 8-28-04 Date well drilling completed: 8-28-04

If flowing, method of flow regulation: Valve N/A Other (describe) _____

Static Water Level: 100' feet above or below (circle one) land surface Date measured: 8-31-04

Method of Measurement (circle one) steel tape electric tape air line other: string and weight

Hole depth: 320' Well depth: 240' Well grouted to a depth of 10 feet

Type of grout (circle one): Cement Bentonite Mix

Casing length: 230' feet Casing diameter: 4 inches Type of casing: pvc

Screen length: 10 feet Screen diameter: 4 inches Type of screen: pvc

Screen slot size: 010 inches Setting depth: From 230 feet to 240 feet

Type of completion (circle all applicable): Gravel packed Underreamed Telescoped Open hole Natural Development

Other (describe): _____

Top of lap pipe or reduction in casing: None feet. If telescoped or more than one screen, describe on back of page

Logs run (circle all applicable): No log run Electric Gamma Ray Density Sonic Neutron Other: _____

Name of organization running log(s): _____


I certify that the well was drilled, constructed, and completed in accordance with all applicable requirements of the Mississippi Department of Environmental Quality and/or the Mississippi Department of Health regulations and state laws.

James W Mason O-620
 Print Name of Water Well Contractor and License No.

James W Mason
 Signature of Water Well Contractor


If well telescopes please sketch below and show depths.

If well telescopes please sketch below and show depths.

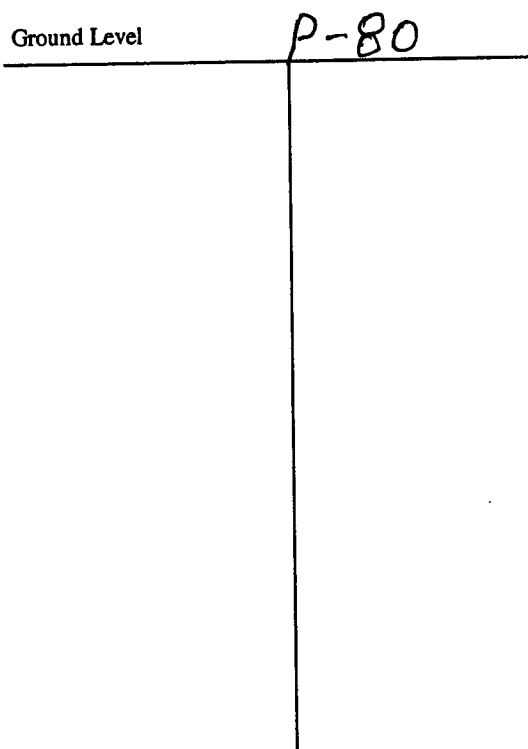

Description of Formations Encountered	From	To
clay dirt	0	15
white sand	15	220
Blue clay	220	225
white sand	225	240
Blue clay	240	270
fine gray sand-	270	320

If more than one screen, show location of each on sketch

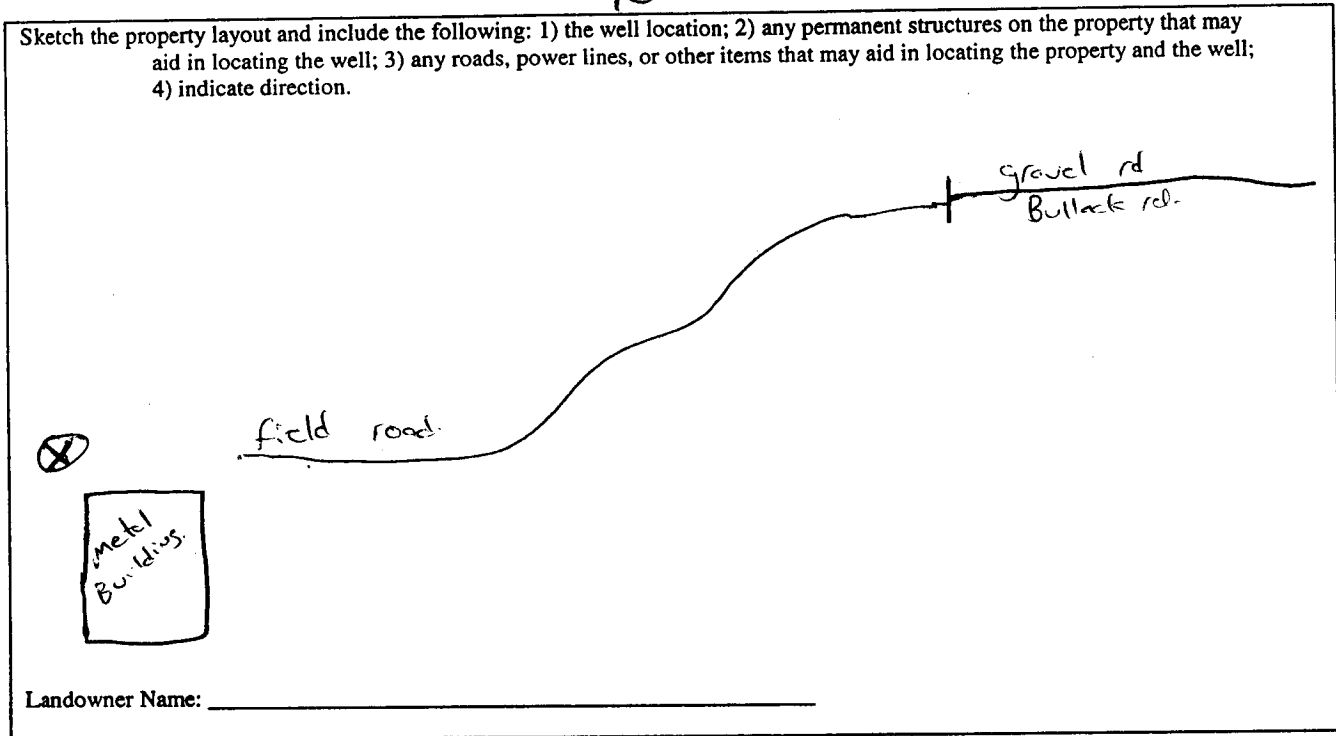

James W. McLean
Signature of Water Well Contractor

STATE WELL REPORT

Part 2

Pump Installer's Completion Report
 Mississippi Department of Environmental Quality
 Office of Land and Water Resources
 P.O. Box 10631
 Jackson, MS 39289-0631
 (601)961-5210
 (601)354-6938 (fax)

For Office Use Only:

Aquifer: _____
 Well #: P-80
 Elevation: _____

County: Marshall
 Permit #: _____
 Driller: James W. Masor
 Date completed: 8-31-04

This report should be prepared by the pump installer in detail and filed with the Department within 30 days of the installation of pump.

Well Owner Information	Well Location
Owner Name: <u>Rick Hudson</u>	Latitude: <u>34-44-033</u> Longitude: <u>89-23-215</u>
Mailing Address: <u>Bullock rd -</u>	Method of Lat/Long (circle one): Conventional Survey,
<i>* Cust has NO physical add. at the very end.</i> <u>Holly Springs MS. 38635</u>	USGS quad, <u>Hand-held GPS</u> , Survey-grade GPS
City State Zip Code	<u>NE 1/4 SW 1/4 Sec 11 Twn 4s Rng 2w</u>
Telephone No. <u>(901) 301-8201</u>	Distance Direction Nearest Town
	<u>2.14 Miles SE of Holly Springs ms.</u>

Pump Type Circle one	Power Type Circle one
Air Lift Jet <u>Submersible</u>	Diesel Engine Gasoline Engine Natural Gas
Bucket Piston Turbine	<u>Electric Motor</u> Hand Tractor PTO
Centrifugal Rotary Flowing Well	Windmill Other (specify): _____
Other (specify): _____	Horse Power Rating of Motor: <u>1 hp.</u>
Date Pump Installed: <u>8-31-04</u>	Setting Depth: <u>140'</u> feet
Rated Pump Capacity: <u>12</u> Gallons Per Minute	Number of Stages: <u>11</u>

Pump Test Data	Method of Measuring Water Level Circle one
Date Well Tested: <u>8-31-04</u>	Air Line Electric Measuring Line Steel Tape
Static Water Level (A): <u>100</u> Feet Below Land Surface	Other (specify): <u>string and weight</u>
Pumping Water Level (B): <u>NA</u> Feet Below Land Surface	For flowing well, measured shut in head: <u>NA</u> feet
Drawdown [(B) - (A)]: <u>NA</u> Feet Below Land Surface	Well yielded <u>12</u> GPM with a drawdown of
Test Pumping Rate: <u>12</u> Gallons Per Minute	<u>NA</u> feet after <u>24</u> hours of pumping
Duration of Pump Test (minimum 4 hours): <u>24</u> hours	

I HEREBY CERTIFY that the above statements are true to the best of my knowledge.

James W. Masor
 Print Name of Pump Installer and License No. (if applicable)

James W. Masor
 Signature of Pump Installer