

MARSHALL
 P 2000
 9-16-75

MISSISSIPPI
 BOARD OF WATER COMMISSIONERS
 416 North State Street
 Jackson, Mississippi 39201

WATER WELL DRILLERS LOG

15F

Sept. 16 1975 R. L. Carpenter Marshall
 date well completed firm name county well located

LANDOWNER: Cabin Chapel Church
Holly Springs
Miss. RFD
 (mailing address)

| description of formations encountered | from | to |
|---------------------------------------|------|-----|
| Surface Soil | 0 | 2 |
| Med. Brown Sand | 2 | 30 |
| Med. White Sand | 30 | 75 |
| White Clay | 75 | 90 |
| White Coarse Sand | 90 | 120 |

WELL LOCATION:
 sec. 21 T. 4 N R. 2 E
3 miles S of Holly Springs
 (distance) (direction) (nearest town)

WELL PURPOSE: Church
 (home, irrigation, municipal, industrial)

WELL COMPLETION DATA:

(1) diameter (inches) 4

(2) total depth (feet) 120

(3) static water level (feet) 48 below above top of ground.

(4) casing Plastic, 114 ft.
 (material) (depth)
 (size) if telescope see back.

(5) screen 6 ft., 114 ft.
 (length) (depth to top)
4 in., Plastic & Lead
 (size) (material)


(6) pump 1/2, 8
 (HP) (yield gpm)
Eber
 (type power)

(7) electric log No.
 (yes or no)

(organization running log)

(8) how well bottom plugged Plastic cap


DRILLERS REMARKS:

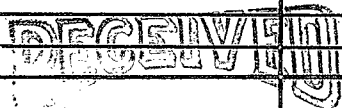

MAR 2 1975

If well telescopes please sketch and show depths.

GROUND LEVEL

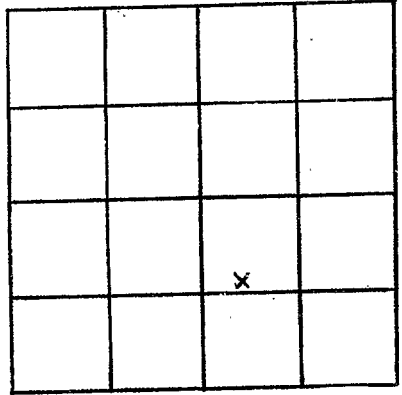

SECTION 21

Please indicate well location X.

ADDITIONAL INFORMATION

If more than one screen, show locations of each on sketch.