


MARSHALL  
 P 2001  
 10-18-75

MISSISSIPPI  
 BOARD OF WATER COMMISSIONERS  
 416 North State Street  
 Jackson, Mississippi 39201

WATER WELL DRILLERS LOG

10-28-75 date well completed  
 Thiabo Well Co. firm name  
 Marshall county well located


LANDOWNER:	description of formations encountered	from	to
Jeremiah Lesure Holly Springs, Miss (mailing address)	Red Clay + Sand	0	15
WELL LOCATION: sec. 4 T. 31 N. R. 2 E. 15F 2 miles SE of Holly Springs (distance) (direction) (nearest town)	White Clay + white Sand	15	45
WELL PURPOSE: Stone (home, irrigation, municipal, industrial)	White Sand	45	164
WELL COMPLETION DATA:			
(1) diameter (inches) 4 1/2			
(2) total depth (feet) 164			
(3) static water level (feet) 90 below top of ground.			
(4) casing Elastic, 164 (material) (depth)			
(size) if telescope see back.			
(5) screen 4 1/2, 157 (length) (depth to top)			
4 1/2, Iron (size) (material)			
(6) pump 1/2 (HP) 10 (yield gpm)			
230 (type power)			
(7) electric log 40 (yes or no)			
(organization running log)			
(8) how well bottom plugged Cap			
DRILLERS REMARKS:			

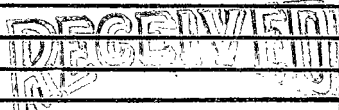

NOV 2 1975

If well telescopes please sketch and show depths.

GROUND LEVEL

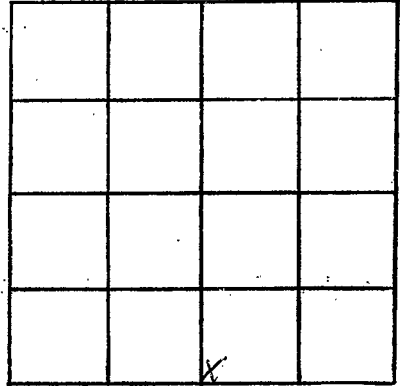

SECTION 4

Please indicate well location X.

ADDITIONAL INFORMATION

If more than one screen, show locations of each on sketch.