

MARSHALL

P 2004
5-12-76

MISSISSIPPI
BOARD OF WATER COMMISSIONERS
416 North State Street
15F Jackson, Mississippi 39201

WATER WELL DRILLERS LOG

5-12 1976 Decontamination well Marshall
date well completed firm name county well located

LANDOWNER:

Eddie White

description of formations encountered

clay

from

to

0 30

Hells Springs, Miss.
(mailing address)

sand

30 150


WELL LOCATION:

sec. 24 T 4 N R 2 E
8 3/4 miles South of Helling
(distance) (direction) (nearest town)

WELL PURPOSE: Drilling
(home, irrigation, municipal, industrial)

WELL COMPLETION DATA:

- (1) diameter (inches) 4"
- (2) total depth (feet) 150 feet
- (3) static water level (feet) 23 feet below top of ground.
- (4) casing PVC (material) 150 feet (depth)
- (size) if telescope see back.
- (5) screen 7ft. (length) 143 feet (depth to top)
- 4" (size) Gravel wall (material)
- (6) pump 3/4 (HP) 14 (yield gpm)
- (type power)
- (7) electric log Elect. (yes or no)
- (organization running log)
- (8) how well bottom plugged 4" cap

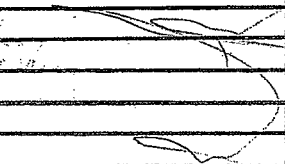


JUN - 8 1976

DRILLERS REMARKS:

MISSISSIPPI WATER COMPANY

If well telescopes please
sketch and show depths.

GROUND LEVEL

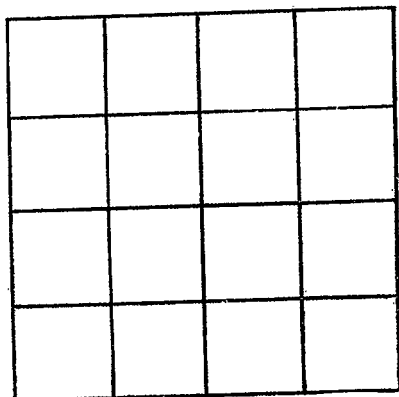

SECTION _____

Please indicate well location X.

ADDITIONAL INFORMATION

If more than one screen,
show locations of each on sketch.