

**MARSHALL**  
 P 2005  
 3-31-76

MISSISSIPPI  
 BOARD OF WATER COMMISSIONERS  
 416 North State Street  
 Jackson, Mississippi 39201

WATER WELL DRILLERS LOG

3-31 1976 Hicks Well Co Marshall  
 date well completed firm name county well located

LANDOWNER: Billy Gray

description of formations encountered

from	to
0	10
10	55
55	145

Holly Springs, Miss. (mailing address)

WELL LOCATION:  
 sec. 4 T. 34 N. R. 2 E  
1 miles (distance) E (direction) of Holly Springs (nearest town)

WELL PURPOSE: HOME  
 (home, irrigation, municipal, industrial)

WELL COMPLETION DATA:

(1) diameter (inches) 4"

(2) total depth (feet) 145

(3) static water level (feet) 80 below/above top of ground.

(4) casing PVC, 138 (material) (depth)  
 (size) If telescope see back.

(5) screen 7' 7' (length) (depth to top)  
4" INSIDE GRAVEL (size) (material)

(6) pump 1/2 10 (HP) (yield gpm)  
220 (type power)

(7) electric log NO (yes or no)  
 (organization running log)


(8) how well bottom plugged CAP

DRILLERS REMARKS:

MISS. BOARD OF WATER COMMISSIONERS  
 MAY 20 1976

If well telescopes please sketch and show depths.

GROUND LEVEL

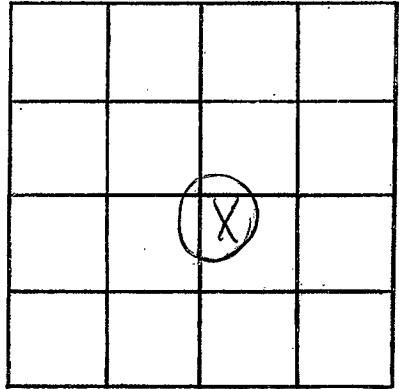

SECTION \_\_\_\_\_

Please indicate well location X.

ADDITIONAL INFORMATION

If more than one screen,  
show locations of each on sketch.