

MARSHALL
P 2006
4-7-76

MISSISSIPPI
 BOARD OF WATER COMMISSIONERS
 416 North State Street
 Jackson, Mississippi 39201

WATER WELL DRILLERS LOG

4-7 19 76 HICKS WELL CO MARSHAL
 date well completed firm name county well located

LANDOWNER: <u>William Kilpatrick</u>	description of formations encountered	from	to
<u>Rt. 2</u>	<u>Red Clay</u>	<u>0</u>	<u>10</u>
<u>Potts Camp, Miss.</u>	<u>White Sand + Clay</u>	<u>10</u>	<u>40</u>
(mailing address)	<u>White Sand</u>	<u>40</u>	<u>150</u>

WELL LOCATION:
 sec. 26 T. 4 N. R. 2 E.
 (S) (W)
2 miles N of LAKE CENTER
 (distance) (direction) (nearest town)

WELL PURPOSE: Home
 (home, irrigation, municipal, industrial)


- WELL COMPLETION DATA:
- (1) diameter (inches) 4"
 - (2) total depth (feet) 150
 - (3) static water level (feet) 90 below above top of ground.
 - (4) casing PVC, 143
 (material) (depth)
 (size) if telescope see back.
 - (5) screen 7' 7'
 (length) (depth to top)
4" Inside GRAVEL
 (size) (material)
 - (6) pump 1/2 10
 (HP) (yield gpm)
220
 (type power)
 - (7) electric log NO
 (yes or no)
 (organization running log)
 - (8) how well bottom plugged CAP

DRILLERS REMARKS:

MAY 20 1976
 WATER QUALITY
 MISSISSIPPI BOARD OF WATER COMMISSIONERS

If well telescopes please sketch and show depths.

GROUND LEVEL

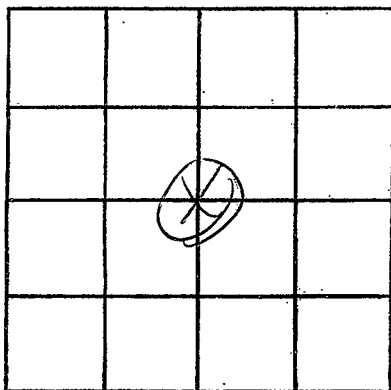

SECTION _____

Please indicate well location X.

ADDITIONAL INFORMATION

If more than one screen,
show locations of each on sketch.