

**MARSHALL**  
**P 2057**  
**4-8-76**

MISSISSIPPI  
 BOARD OF WATER COMMISSIONERS  
 416 North State Street  
 Jackson, Mississippi 39201

WATER WELL DRILLERS LOG

4-8 1976 Hicks Well Co. Marshall  
 date well completed firm name county well located

LANDOWNER: Leo Bogard  
Rt. 1  
Holly Springs, Miss.  
 (mailing address)

description of formations encountered	from	to
Red clay	0	10
Red sand	10	40
White sand & clay	40	150
White sand	150	245

WELL LOCATION:  
 sec. 2 T. 4 N. R. 2 E.  
2 1/2 miles NE of Holly Springs  
 (distance) (direction) (nearest town)

WELL PURPOSE: Home  
 (home, irrigation, municipal, industrial)


- WELL COMPLETION DATA:
- (1) diameter (inches) 4"
  - (2) total depth (feet) 245
  - (3) static water level (feet) 150 below above top of ground.
  - (4) casing PVC, 232  
 (material) (depth)  
 (size) if telescope see back.
  - (5) screen 7', 7'  
 (length) (depth to top)  
4", Inside Gravel  
 (size) (material)
  - (6) pump 3/4, 12  
 (HP) (yield gpm)  
220  
 (type power)
  - (7) electric log NO  
 (yes or no)
  - (organization running log)
  - (8) how well bottom plugged CAP

DRILLERS REMARKS:

MAY 20 1976  
 MISS. BD. OF WATER COMMISSIONERS

If well telescopes please sketch and show depths.

GROUND LEVEL

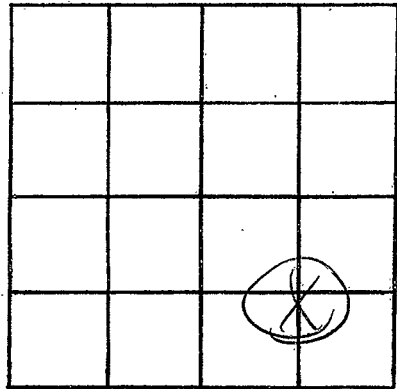

SECTION \_\_\_\_\_

Please indicate well location X.

ADDITIONAL INFORMATION

If more than one screen, show locations of each on sketch.