

Marshall
 P 2009
 6-30-76

MISSISSIPPI
 BOARD OF WATER COMMISSIONERS
 416 North State Street
 Jackson, Mississippi 39201

WATER WELL DRILLERS LOG

6-30 1976 ^{15F} Hicks Well Co. Marshall
 date well completed firm name county well located

LANDOWNER: Aunt Jeffrie Pt. 5	Description of formations encountered	from	to
		Red clay	0
Holly Springs, Miss (mailing address)	White sand clay	10	140
	White sand	140	185

WELL LOCATION:
 sec. 8 T. 4 N R. 2 E
 1 miles SE of Holly Springs
 (distance) (direction) (nearest town)

WELL PURPOSE: Home
 (home, irrigation, municipal, industrial)

- WELL COMPLETION DATA:
- (1) diameter (inches) 4"
 - (2) total depth (feet) 185
 - (3) static water level (feet) 120 below top of ground.
 - (4) casing PVC (material), 185 (depth)
 - (size) If telescope see back.
 - (5) screen 4 ft. (length), 181 (depth to top)
 - 4 in. gravel (size) (material)
 - (6) pump 1/2 (HP), 10 (yield gpm)
 - 220 (type power)
 - (7) electric log No (yes or no)
 - (organization running log)
 - (8) how well bottom plugged Cap


DRILLERS REMARKS:

RECEIVED
 JUL 28 1976

MISS. BD. OF WATER

If well telescopes please sketch and show depths.

GROUND LEVEL

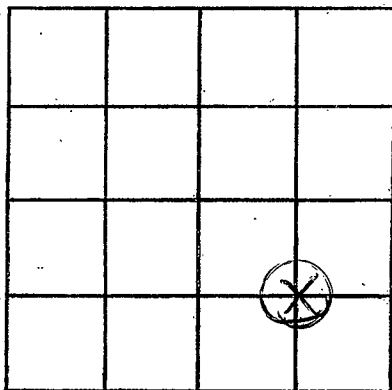

SECTION

8

Please indicate well location X.

ADDITIONAL INFORMATION

If more than one screen, show locations of each on sketch.