

MARSHALL

P 2010

10-7-76

MISSISSIPPI
 BOARD OF WATER COMMISSIONERS
 416 North State Street
 15F Jackson, Mississippi 39201

WATER WELL DRILLERS LOG

10-7-1976 date well completed

Robert W. W. Leon firm name

Marshall county well located

LANDOWNER:

Claude Binson
P.O. #4531
Holly Springs, Miss
C (mailing address)

description of formations encountered

from to

Red clay	0	10
Red sand	10	60
white sand	60	117
white clay & sand	117	124
white sand	124	225

WELL LOCATION:

sec. 1 T. 4 N. R. 2 E. W. 1

miles of (distance) (direction) (nearest town)

WELL PURPOSE:

(home, irrigation, municipal, industrial)

WELL COMPLETION DATA:

- (1) diameter (inches) 4
- (2) total depth (feet) 225
- (3) static water level (feet) 160 below above top of ground.
- (4) casing 2 1/2" (material) (depth)
- (size) if telescope see back.
- (5) screen 4 (length) (depth to top)
- (size) gravel packed (material)
- (6) pump 3/4 (HP) 10 (yield gpm)
- (type power) electric
- (7) electric log (yes or no)
- (organization running log)

(8) how well bottom plugged 4"

plastic cap


DRILLERS REMARKS:

RECEIVED
MAR 11 1977

MISS. BD. OF WATER COMM.

If well telescopes please sketch and show depths.

GROUND LEVEL

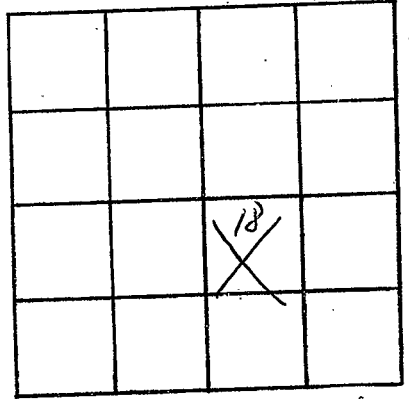

SECTION ~~775~~ 2

Please indicate well location X.

ADDITIONAL INFORMATION

If more than one screen, show locations of each on sketch.