

Marshall
P 2011
5-13-77

MISSISSIPPI
BOARD OF WATER COMMISSIONERS
416 North State Street
15F Jackson, Mississippi 39201

WATER WELL DRILLERS LOG

5-13 1977 Hick Well Co. Marshall
date well completed firm name county well located


LANDOWNER: <u>Robert Sims</u>	description of formations encountered	from	to
<u>Waterford, Ms.</u> (mailing address)	<u>Red Clay</u>	<u>0</u>	<u>30</u>
WELL LOCATION:	<u>White Sand</u>	<u>30</u>	<u>180</u>
sec. <u>30</u> T. <u>45</u> N. R. <u>2W</u>	<u>White Clay</u>	<u>190</u>	<u>195</u>
<u>2</u> miles <u>N</u> of <u>Waterford</u> (distance) (direction) (nearest town)	<u>White Sand</u>	<u>195</u>	<u>225</u>
WELL PURPOSE: <u>Home</u> (home, irrigation, municipal, industrial)			
WELL COMPLETION DATA:			
(1) diameter (inches) <u>4</u>			
(2) total depth (feet) <u>225</u>			
(3) static water level (feet) <u>190</u> below top of ground.			
(4) casing <u>PVC</u> , <u>225</u> (material) (depth) (size) if telescope see back.			
(5) screen <u>7'</u> , <u>183'</u> (length) (depth to top)			
<u>4"</u> , <u>gravel type</u> (size) (material)			
(6) pump <u>3/4</u> , <u>70</u> (HP) (yield gpm)			
<u>220V</u> (type power)			
(7) electric log <u>No</u> (yes or no)			
(organization running log)			
(8) how well bottom plugged <u>Cap</u>			
DRILLERS REMARKS:			

RECEIVED
JUL 13 1977

MISS. BD. OF WATER COMMISSIONERS

If well telescopes please sketch and show depths.

GROUND LEVEL

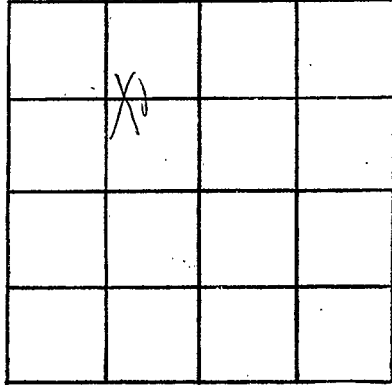

SECTION 30

Please indicate well location X.

ADDITIONAL INFORMATION

If more than one screen, show locations of each on sketch.