

MARSHALL
P 2013
6-20-77

MISSISSIPPI
BOARD OF WATER COMMISSIONERS
416 North State Street
Jackson, Mississippi 39201

WATER WELL DRILLERS LOG

6-20-1977 date well completed
Kick Well Co. firm name
Marshall county well located

LANDOWNER: Wattie Peoples
Rt. 2, Box 175
Potts Camp, Ms.
(mailing address)

description of formations encountered	from.	to
Red clay	0	20
Red sand + clay	20	60
White sand	60	105
White sand clay	105	140

WELL LOCATION:
sec. 35 T 4 N R 2 E
1 miles (distance) E of Lake Center (direction) (nearest town)

WELL PURPOSE: Home
(home, irrigation, municipal, industrial)

WELL COMPLETION DATA:

(1) diameter (inches) 4

(2) total depth (feet) 140

(3) static water level (feet) 120 below top of ground.

(4) casing PVC (material) 140 (depth)

(size) if telescope see back.

(5) screen 20 ft (length) 20 ft (depth to top)

4" (size) gravel type (material)

(6) pump 42 (HP) 10 (yield gpm)

220V (type power)

(7) electric log no (yes or no)

(organization running log)

(8) how well bottom plugged Cap


DRILLERS REMARKS:

RECEIVED
JUL 14 1977

MISS. BD. OF WATER COMMISSIONERS

If well telescopes please sketch and show depths.

GROUND LEVEL

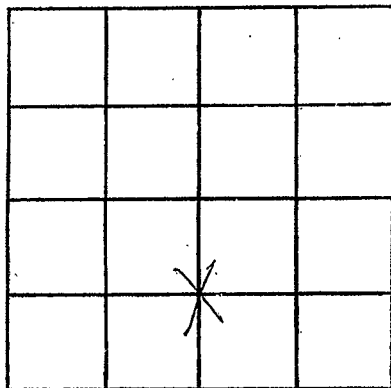

SECTION 35

Please indicate well location X.

ADDITIONAL INFORMATION

If more than one screen, show locations of each on sketch.