

MARSHALL
 P 2014
 7/14/77

MISSISSIPPI
 BOARD OF WATER COMMISSIONERS
 416 North State Street
 15F Jackson, Mississippi 39201

WATER WELL DRILLERS LOG

7-14-77 19 Hicks Well Co Marshall
 date well completed firm name county well located

LANDOWNER: Clayton Collins
Rt. 1 Holly Springs
 (mailing address)

description of formations encountered	from	to
red clay	0	20
red sand	20	160
white sand	160	240

WELL LOCATION:
 sec. 11 T 4 N R 2 E
3 miles SE of Holly Springs
 (distance) (direction) (nearest town)

WELL PURPOSE: Home
 (home, irrigation, municipal, industrial)

- WELL COMPLETION DATA:
- (1) diameter (inches) 4"
 - (2) total depth (feet) 240
 - (3) static water level (feet) 200 below above top of ground.
 - (4) casing PVC (material) (depth) (size) if telescope see back.
 - (5) screen 7' 7' (length) (depth to top) 4" (size) inside rock (material)
 - (6) pump 3/4 10 (HP) (yield gpm) Electric (type power)
 - (7) electric log (yes or no)
 - (organization running log)
 - (8) how well bottom plugged Comp

DRILLERS REMARKS:


RECEIVED

AUG 19 1977

MISS. BD. OF WATER COMMISSIONERS

If well telescopes please sketch and show depths.

GROUND LEVEL

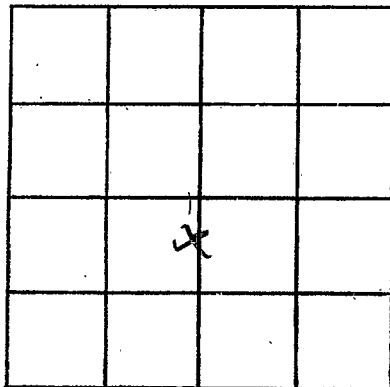

SECTION _____

Please indicate well location X.

ADDITIONAL INFORMATION

If more than one screen, show locations of each on sketch.