

Marshall
P 2015
7-15-77

MISSISSIPPI
 BOARD OF WATER COMMISSIONERS
 416 North State Street
 Jackson, Mississippi 39201

15F

WATER WELL DRILLERS LOG

7-15-77
 date well completed

Hicks well CD
 firm name

Marshall
 county well located

LANDOWNER: Alfred TINDY
RT-1 Holly Springs
 (mailing address)

description of formations encountered	from	to
<u>RC</u>	<u>0</u>	<u>10</u>
<u>white s clay</u>	<u>10</u>	<u>120</u>
<u>WS</u>	<u>120</u>	<u>170</u>

WELL LOCATION:
 sec. 4 - T. 4 N. R. 2 E.
1 1/2 miles S/E of Holly Springs
 (distance) (direction) (nearest town)

WELL PURPOSE: HOME
 (home, irrigation, municipal, industrial)

- WELL COMPLETION DATA:
- (1) diameter (inches) 4"
 - (2) total depth (feet) 140
 - (3) static water level (feet) 57 below top of ground.
 - (4) casing PVC 137
 (material) (depth)
 - (size) If telescope see back.
 - (5) screen 7' 7'
 (length) (depth to top)
 - 4" inside Rock
 (size) (material)
 - (6) pump 1/2 10
 (HP) (yield gpm)
 - Elec
 (type power)
 - (7) electric log yes or no
 - (organization running log)
 - (8) how well bottom plugged cap

RECEIVED


AUG 18 1977

DRILLERS REMARKS:

MISS. BD. OF WATER COMM

If well telescopes please sketch and show depths.

GROUND LEVEL

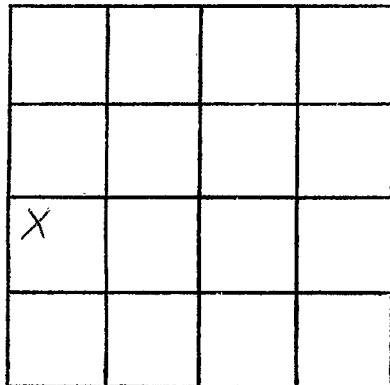

SECTION _____

Please indicate well location X.

ADDITIONAL INFORMATION

If more than one screen,
show locations of each on sketch.