

MARSHALL
P 2016
7-18-77

MISSISSIPPI
BOARD OF WATER COMMISSIONERS
416 North State Street
Jackson, Mississippi 39201

WATER WELL DRILLERS LOG

7-18-77 19 date well completed
Hicks well CO firm name
Marshall county well located

LANDOWNER: Lemon Hughes
Holly Springs, Miss
(mailing address)

WELL LOCATION:
sec 4 T 4 N R 2 E
1/2 miles S/E of Holly SP
(distance) (direction) (nearest town)

WELL PURPOSE: Home
(home, irrigation, municipal, industrial)

- WELL COMPLETION DATA:
- (1) diameter (inches) 4"
 - (2) total depth (feet) 160
 - (3) static water level (feet) 100 below top of ground.
 - (4) casing PVC (material) 153 (depth)
(size) if telescope see back.
 - (5) screen 7' (length) 7' (depth to top)
4" (size) inside rock (material)
 - (6) pump 1/2 (HP) 10 (yield gpm)
Elec (type power)
 - (7) electric log (yes or no)
 - (organization running log)
 - (8) how well bottom plugged Cap

description of formations encountered	depth	
	from	to
Red Clay	0	10
Red Sand	10	30
WS	20	90
WS 20/24	70	120
WS	120	160

RECEIVED


AUG 18 1977

DRILLERS REMARKS:

MISS. BD. OF WATER COMMISSIONERS

If well telescopes please sketch and show depths.

GROUND LEVEL

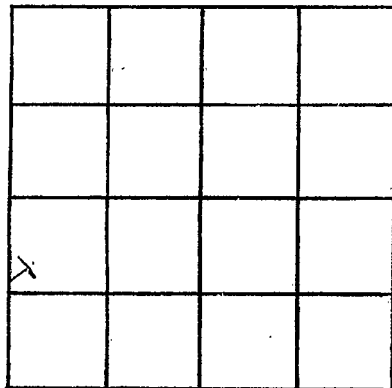

SECTION _____

Please indicate well location X.

ADDITIONAL INFORMATION

If more than one screen,
show locations of each on sketch.