

Marshall
P 2018
8-19-77

MISSISSIPPI
BOARD OF WATER COMMISSIONERS
416 North State Street
15F Jackson, Mississippi 39201

WATER WELL DRILLERS LOG

8-19-1977 date well completed
Hick Well Co. firm name
Marshall county well located

LANDOWNER: Lucy Hubbard
Rt. 1
Holly Springs, Ms.
(mailing address)

| description of formations encountered | from | to |
|---------------------------------------|------|-----|
| Red Clay | 0 | 30 |
| Red Clay + Sand | 30 | 60 |
| White Sand | 60 | 100 |

WELL LOCATION:
sec. 16 T 4 N R 2 E
4 miles SE of Holly Springs
(distance) (direction) (nearest town)

WELL PURPOSE: Home
(home, irrigation, municipal, industrial)

- WELL COMPLETION DATA:
- (1) diameter (inches) 4
 - (2) total depth (feet) 100
 - (3) static water level (feet) 60 below top of ground.
 - (4) casing RUC, 180 (material), (depth)
 - (size) If telescope see back.
 - (5) screen 7' 93 (length), (depth to top)
 - 4, gravel type (size), (material)
 - (6) pump 42 10 (HP), (yield gpm)
 - 220V (type power)
 - (7) electric log 970 (yes or no)


(organization running log)
(8) how well bottom plugged Cap

DRILLERS REMARKS:

RECEIVED
OCT 17 1977
MS. DEPT. OF WATER COMMISSIONERS

If well telescopes please sketch and show depths.

GROUND LEVEL

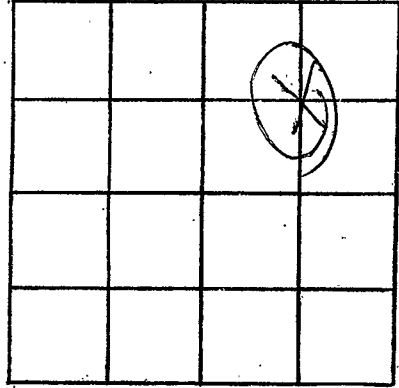

SECTION 16

Please indicate well location X.

ADDITIONAL INFORMATION

If more than one screen, show locations of each on sketch.