

MARSHALL
P
2020

MISSISSIPPI
 BOARD OF WATER COMMISSIONERS
 416 North State Street
 Jackson, Mississippi 39201

WATER WELL DRILLERS LOG

6-16-19 78 Hicks Well Co Marshall
 date well completed firm name county well located

LANDOWNER: <u>Rosevelt Le Sueur</u>	description of formations encountered	from	to
		<u>Holly Springs, Ms.</u> (mailing address)	<u>Red Clay</u>
	<u>white sand</u>	<u>10</u>	<u>265</u>

WELL LOCATION:
 sec 24 T 4 N R 2 E
32 miles (distance) N (direction) of Jacks Cent (nearest town)

WELL PURPOSE: Home
 (home, irrigation, municipal, industrial)

WELL COMPLETION DATA:

(1) diameter (inches) 4

(2) total depth (feet) 265

(3) static water level (feet) 180 below top of ground.

(4) casing PVC (material), 265 (depth)

 (size) If telescope see back.

(5) screen 7 (length), 252 (depth to top)

1/2" (size), gravel type (material)


(6) pump 3/4 (HP), 10 (yield gpm)

220V (type power)

(7) electric log No (yes or no)

 (organization running log)

(8) how well bottom plugged Cap

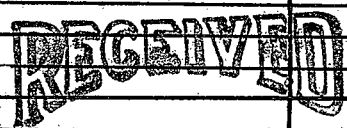


JUN 29 1978

DRILLERS REMARKS:

MISS. Bd. OF WATER COM.

If well telescopes please sketch and show depths.

GROUND LEVEL

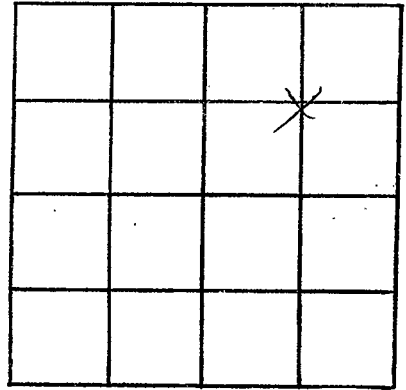

SECTION 24

Please indicate well location X.

ADDITIONAL INFORMATION

If more than one screen,
show locations of each on sketch.