

MARSHALL
P 2025
9-15-78

**MISSISSIPPI
BOARD OF WATER COMMISSIONERS**
416 North State Street
Jackson, Mississippi 39201
WATER WELL DRILLERS LOG

9-15 date well completed 1978 Hicks Well Co firm name Marshall county well located

LANDOWNER: <u>VERA STINSON</u>	description of formations encountered	from	to
<u>RT. 2</u>			
<u>POTT'S CAMP</u> (mailing address)	<u>Red SAND</u>	<u>15</u>	<u>100</u>
	<u>W. S.</u>	<u>100</u>	<u>145</u>

WELL LOCATION:
 sec 27 T 4 N R 2 E
 (distance) 1 1/2 miles N/E of LAKE CIVIC
 (direction) (nearest town)

WELL PURPOSE: HAMP
 (home, irrigation, municipal, industrial)

- WELL COMPLETION DATA:**
- diameter (inches) 4"
 - total depth (feet) 145
 - static water level (feet) 118 below top of ground.
 - casing PVC 145
(material) (depth)
 - if telescope see back.
(size)
 - screen 7' 7'
(length) (depth to top)
#2 INSIDE ROCK
(size) (material)
 - pump 1/2 10
(HP) (yield gpm)
250 EIBC
(type power)
 - electric log NO
(yes or no)
(organization running log)
 - how well bottom plugged CAP


DRILLERS REMARKS:

RECEIVED
 SEP 25 1978

MISS. BD. OF WATER COMM

If well telescopes please sketch and show depths.

GROUND LEVEL

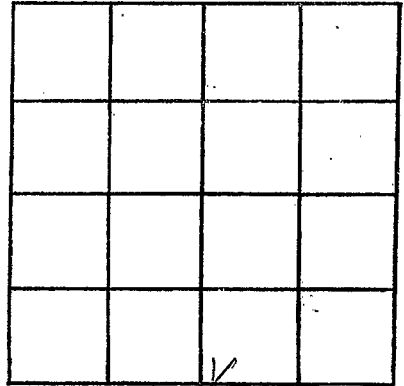

SECTION _____

Please indicate well location X.

ADDITIONAL INFORMATION

If more than one screen,
show locations of each on sketch.