

MARSHALL
P 2022
9-13-78

**MISSISSIPPI  
BOARD OF WATER COMMISSIONERS**  
416 North State Street  
Jackson, Mississippi 39201

**WATER WELL DRILLERS LOG**

9-13-78 19 Hicks Well Co. Marshall  
 date well completed firm name county well located

LANDOWNER: Margaret Finkins  
Rt. 2 Potts Camp  
Miss  
 (mailing address)

description of formations encountered	from	to
	<u>Red clay</u>	<u>0</u>
<u>Red sand</u>	<u>15</u>	<u>90</u>
<u>White sand</u>	<u>90</u>	<u>155</u>

WELL LOCATION:  
 sec. 26 T 4 N R 2 E  
1 miles North of Lake Circle  
 (distance) (direction) (nearest town)

WELL PURPOSE: Home  
 (home, irrigation, municipal, industrial)

WELL COMPLETION DATA:

(1) diameter (inches) 4"

(2) total depth (feet) 155

(3) static water level (feet) 125 below top of ground.

(4) casing PVC, 155,  
 (material) (depth)

\_\_\_\_\_ If telescope see back.  
 (size)

(5) screen 7', 7'  
 (length) (depth to top)

4" 62, INSIDE ROCK  
 (size) (material)

(6) pump 1/2, 10  
 (HP) (yield gpm)

220 Elec  
 (type power)

(7) electric log NO  
 (yes or no)

\_\_\_\_\_ (organization running log)

(8) how well bottom plugged CAD


DRILLERS REMARKS:

**RECEIVED**  
 SEP 25 1978

MISS. BD OF WATER COMMISSIONERS

If well telescopes please sketch and show depths.

GROUND LEVEL

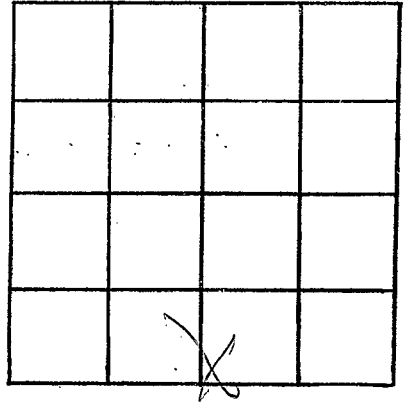

SECTION \_\_\_\_\_

Please indicate well location X.

ADDITIONAL INFORMATION

If more than one screen,  
show locations of each on sketch.