

MARSHALL
P
9-12-78
2023

**MISSISSIPPI
BOARD OF WATER COMMISSIONERS**
416 North State Street
Jackson, Mississippi 39201

WATER WELL DRILLERS LOG

9-12-78 to HICKS Well Co Mississippi
 date well completed firm name county well located

LANDOWNER: Autrey Hicks
Holly Springs, Miss
 (mailing address)

description of formations encountered	from	to
Red sand	0	15
White clay sand	15	85
Red sand	85	120
White sand	120	157

WELL LOCATION:
 sec. 4 T. 4 N. R. 4 E. 2
Behind Ford Dealer, Holly Springs
 (distance) miles (direction) (nearest town)

WELL PURPOSE: Home
 (home, irrigation, municipal, industrial)

WELL COMPLETION DATA:

(1) diameter (inches) 4"

(2) total depth (feet) 157

(3) static water level (feet) 80 below above top of ground.

(4) casing PVC, 157,
 (material) (depth)
 (size) If telescope see back.

(5) screen 7', 7'
 (length) (depth to top)
#2-02, Inside Rock
 (size) (material)

(6) pump 1/2 10
 (HP) (yield gpm)
220 F10
 (type power)

(7) electric log N
 (yes or no)
 (organization running log)

(8) how well bottom plugged CAP


DRILLERS REMARKS:

RECEIVED
SEP 25 1978

MISS. Bd. OF WATER COMM.

If well telescopes please sketch and show depths.

GROUND LEVEL

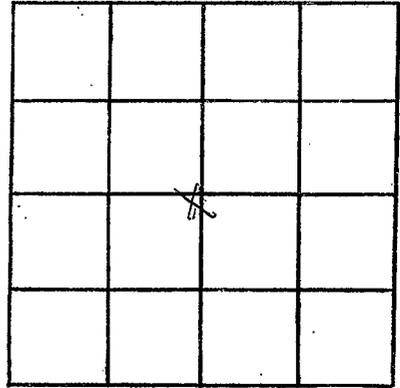

SECTION _____

Please indicate well location X.

ADDITIONAL INFORMATION

If more than one screen,
show locations of each on sketch.