

MARSHALL
 P
 11-30-78
 2025

MISSISSIPPI
 BOARD OF WATER COMMISSIONERS
 416 North State Street
 Jackson, Mississippi 39201

WATER WELL DRILLERS LOG

11-30-78 date well completed
 Hick Well Co firm name
 Marshall county well located

LANDOWNER: Nathaniel Holloway
 Pt. 1
 Holly Springs, TN
 (mailing address)

description of formations encountered	from	to
Red sand	0	5
White sand	5	15
White sand + clay	15	90
White sand	90	245

WELL LOCATION:
 sec. 11 T. 4 N. R. 2 E. W. 5
 (distance) miles (direction) off (nearest town)

WELL PURPOSE: Home
 (home, irrigation, municipal, industrial)

WELL COMPLETION DATA:
 (1) diameter (inches) 4"
 (2) total depth (feet) 245
 (3) static water level (feet) 110 below top of ground.
 (4) casing PVC 245 (material) (depth)
 (size) If telescope see back.
 (5) screen 4' 23' 5" (length) (depth to top)
 4" gravel type (size) (material)
 (6) pump 3/4 10 (HP) (yield gpm)
 220V (type power)
 (7) electric log Yes (yes or no)


(organization running log)
 (8) how well bottom plugged Cap

DRILLERS REMARKS:

RECEIVED
 DEC 14 1978

If well telescopes please sketch and show depths.

GROUND LEVEL

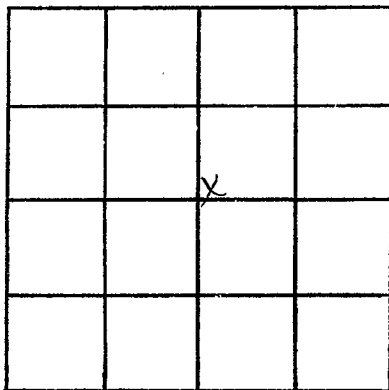

SECTION 11

Please indicate well location X.

ADDITIONAL INFORMATION

If more than one screen,
show locations of each on sketch.