

MARSHALL

P 2006

5-15-79

MISSISSIPPI BOARD OF WATER COMMISSIONERS  
416 North State Street  
Jackson, Mississippi 39201

WATER WELL DRILLERS LOG

5-15  
date well completed

1979 Deane & Co. Drilling & Pumping  
firm name

Marshall  
county well located

LANDOWNER:

Larry Luther  
Haley Springs, Miss.  
(mailing address)

description of formations encountered

from

to

Clay 0 45  
Sand 45 227

WELL LOCATION:

sec. 3 T 4 N R 2 E  
3 miles East of Nettie  
(distance) (direction) (nearest town)

WELL PURPOSE: Domestic  
(home, irrigation, municipal, industrial)

WELL COMPLETION DATA:

- (1) diameter (inches) 4"
- (2) total depth (feet) 227 feet
- (3) static water level (feet) 160 below top of ground.
- (4) casing PVC, 227 feet (material) (depth)  
(size) if telescope see back.
- (5) screen 70 feet, 220 feet (length) (depth to top)  
4" sand wash (size) (material)
- (6) pump 3/4 HP, 14 (yield gpm)  
(type power)
- (7) electric log Elect. (yes or no)
- (organization running log)
- (8) how well bottom plugged 4" cap.

DRILLERS REMARKS:


Miss. Board of Water Comm.

MAY 21 1979

RECEIVED

If well telescopes please sketch and show depths.

GROUND LEVEL

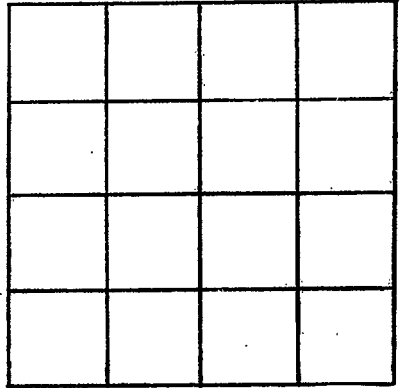

SECTION \_\_\_\_\_

Please indicate well location X.

ADDITIONAL INFORMATION

If more than one screen, show locations of each on sketch.