

MARSHALL
 P 2007
 2/10/79
 Feb. 10

MISSISSIPPI
 BOARD OF WATER COMMISSIONERS
 416 North State Street
 Jackson, Mississippi 39201

WATER WELL DRILLERS LOG

date well completed 19 79 firm name R. L. Carpenter county well located Marshall

LANDOWNER: John Davis
Both Camp, Miss
RFD
 (mailing address)

description of formations encountered	from	to
Surface Soil	0	15
Med. Coars	15	34
Red Sand		
Med. white Sand	34	60
white Clay	60	86
White coarse Sand	86	118

WELL LOCATION:
 sec. ~~25~~ T 4 N R 7 E
 S W
 5 miles SE of 745
 (distance) (direction) (nearest town)

WELL PURPOSE: Home
 (home, irrigation, municipal, industrial)


- WELL COMPLETION DATA:
- (1) diameter (inches) 4
 - (2) total depth (feet) 118
 - (3) static water level (feet) 82 below above top of ground.
 - (4) casing Plastic, 108'
 (material) (depth)
 (size) if telescope see back.
 - (5) screen 10', 108'
 (length) (depth to top)
4", Plastic
 (size) (material)
 - (6) pump 1/2 10
 (HP) (yield gpm)
Elec.
 (type power)
 - (7) electric log no
 (yes or no)
 - (organization running log)
 - (8) how well bottom plugged PVC cap

DRILLERS REMARKS:

DEPT. OF NATURAL RESOURCES
 BUREAU OF LAND & WATER RESOURCES
 MAY 18 1979
 RECEIVED

If well telescopes please sketch and show depths.

GROUND LEVEL

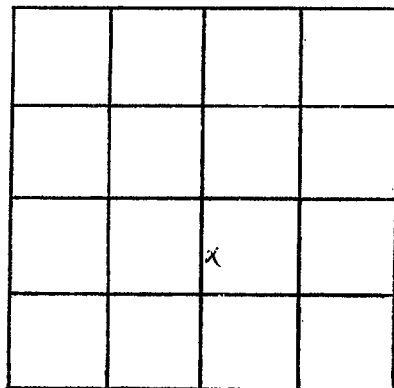

SECTION 25

Please indicate well location X.

ADDITIONAL INFORMATION

If more than one screen,
show locations of each on sketch.