

MARSHALL
P 2028
5-14-79

MISSISSIPPI
BOARD OF WATER COMMISSIONERS
416 North State Street
Jackson, Mississippi 39201

WATER WELL DRILLERS LOG

5-14-79 date well completed Rich W. Wells firm name Marshall county well located

LANDOWNER:
Lammie Tucker
Holly Springs, Miss.
(mailing address)

description of formations encountered	from	to
Red Clay	0	20
Red Sand	20	70
Red Sand & Red Clay	70	95
W. white sand	95	155

WELL LOCATION:
sec. 9 T 2 N R 2 E
2 miles S E of Holly Springs
(distance) (direction) (nearest town)

WELL PURPOSE: none
(home, irrigation, municipal, industrial)

WELL COMPLETION DATA:

(1) diameter (inches) 4 in

(2) total depth (feet) 155 ft

(3) static water level (feet) _____ below top of ground above

(4) casing Plastic 155 ft
(material) (depth)

(size) if telescope see back.

(5) screen 2 ft, 148 ft
(length) (depth to top)

4 in gravel
(size) (material)

(6) pump 1/2 10
(HP) (yield gpm)

220
(type power)

(7) electric log No
(yes or no)

(organization running log)

(8) how well bottom plugged Cap

DRILLERS REMARKS:


Miss. Board of Water Comm.

JUN 1 1979

RECEIVED

If well telescopes please sketch and show depths.

GROUND LEVEL

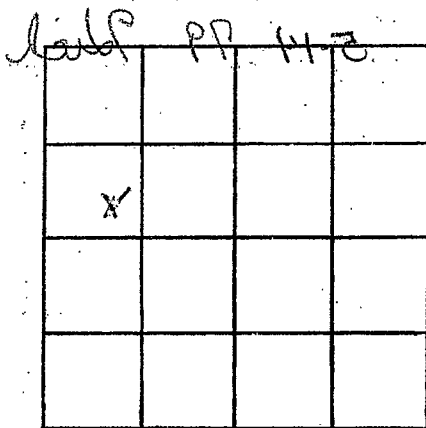

SECTION 9

Please indicate well location X.

ADDITIONAL INFORMATION

If more than one screen, show locations of each on sketch.